

IOSCO COUNTY REMONUMENTATION  
LAND CORNER RECORDATION CERTIFICATE  
Filing Requirement of Act 74, Mich. P.A. 1970

STATE OF MICHIGAN  
IOSCO COUNTY  
FILED

For corners in

IOSCO (County)	Located In:	Corner Code #
1. Public Land Survey	T 22N R 9E	A-3
	T ___ R ___	___
	T ___ R ___	___
	T ___ R ___	___
2. Property Controlling in Section	S ___ T ___ R ___	___
	S ___ T ___ R ___	___
3. Miscellaneous Property in Sec.	S ___ T ___ R ___	___
	S ___ T ___ R ___	___

12 DEC 95 2:29 P.M.

RONITA K. COYLE  
REGISTER OF DEEDS

Register of Deeds Stamp & File Number

4. Lot No. \_\_\_\_\_, Recorded Plat \_\_\_\_\_  
5. Private Claims \_\_\_\_\_

I, WILLIAM E. WOODS in a field survey on 11-2-, 1995 do hereby state that under requirements of P.A. 74, Michigan P.A. of 1970, the corner points mentioned in lines 1 and 2 above were in conformance with regulations and rules therefore as required in the current manual of survey instructions of the United States Department of the Interior, Bureau of Land Management or by a decree of a Court of Law and /or that the corner points mentioned in lines 3, 4 and 5 above were in conformance with the rules of the Michigan Board of Land Surveyors or by a Decree of a Court of Law, established, re-established, monumented, recovered, found as expressed below:

NOTE: Not more than 2 corners, all in the same town and range, may be recorded on this certificate.

	A	B	C	D	E	F	G	H	I	J	K	L	M
1													
2	6			5			4			3			1
3													
4	7			8			9			10			12
5													
6	18			17			16			15			13
7													
8	19			20			21			22			24
9													
10	30			29			28			27			25
11													
12	31			32			33			34			36
13													

A. Description of original monument and accessories and/or subsequent restoration:

1843: JOHN MALLET D.S. SET WOOD POST IN POND.  
8" SPRUCE PINE S76°E 27 LK.  
6" SPRUCE PINE N58°W 66 LK.

B. Description of corner evidence found and/or method applied in restoring or reestablishing corner:

1992: N.E.L.S. CORNER IS IN POND. FOUND BRASS CAP ON 1/16  
WILLIAM E. WOODS CORNER SOUTH OF A-3 DOUBLED DISTANCE TO  
NORTH TO ESTABLISHED POSITION FOR A-3.

ACCEPTED BY THE IOSCO COUNTY  
SURVEY PEER GROUP AS THE  
OFFICIAL CORNER UNDER P.A.  
345 OF 1990 AT A MEETING  
HELD ON 10-31-95

*James H. Granger*


C. Description of monument for corner and accessories established to perpetuate locating the position of the corner:

1995: REMONUMENTATION WILLIAM E. WOODS P.S. 25882

SET 5/8" BAR WITH ALUMINUM CAP AT 1/16  
CORNER ON WEST LINE 1295.77 SOUTH OF A-3.

6" J.PINE S65°E 40.15  
6" J.PINE S35°E 53.28  
6" J.PINE S75°E 63.08  
4" J.PINE S5°E 72.80

SET 5/8 BAR WITH ALUMINUM CAP  
ON NORTH SEC. LINE 1234.15 FT.  
EAST OF A-3  
36" TRIPLE MAPLE S8°W 29.13  
12" MAPLE S32°W 32.57  
24" MAPLE S19°E 87.21  
26" MAPLE N34°E 39.22  
24" BIRCH N50°E 6.49

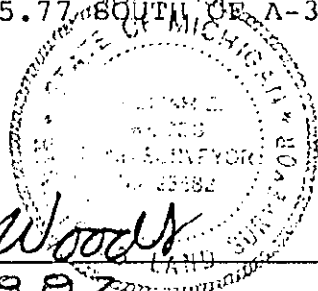

Signed by William E Woods  
Surveyor's Michigan License No. 25802

Date 12-8-95