

1995

IOSCO COUNTY REMONUMENTATION  
LAND CORNER RECORDATION CERTIFICATE  
Filing Requirement of Act 74, Mich. P.A. 1970

95-36

STATE OF MICHIGAN  
IOSCO COUNTY  
FILED

12 DEC 95 2:30 P.M.

BONITA A. COYLE  
REGISTER OF DEEDS

Register of Deeds Stamp & File Number

corners in

IOSCO (County)	Located In:	Corner Code #
Public Land Survey	T 22N R 9E	A-4
	T R	
	T R	
	T R	
Property Controlling in Section	S T R	
Miscellaneous	S T R	
Property in Sec.	S T R	

Lot No. \_\_\_\_\_, Recorded Plat \_\_\_\_\_  
Private Claims \_\_\_\_\_

WILLIAM E. WOODS in a field survey on 10-2-1995 do hereby state that under requirements of P.A. 74, Michigan P.A. of 1970, the corner points mentioned in lines 1 and 2 above were in conformance with regulations and rules therefore as required in the current manual of survey instructions of the United States Department of the Interior, Bureau of Land Management or by a decree of a Court of Law and/or that the corner points mentioned in lines 3, 4 and 5 above were in conformance with the rules of the Michigan Board of Land Surveyors or by a Decree of a Court of Law; established, re-established, monumented, recovered, found as expressed below:

NOTE: Not more than 2 corners, all in the same town and range, may be recorded on this certificate.

	A	B	C	D	E	F	G	H	I	J	K	L	M
1													
2	6		5		4		3		2				
3													
4	7		8		9		10		11		12		
5													
6	18		17		16		15		14		13		
7													
8	19		20		21		22		23		24		
9													
10	30		29		28		27		26		25		
11													
12	31		32		33		34		35		36		
13													

A. Description of original monument and accessories and/or subsequent restoration:  
1843 ORIGINAL SURVEY, J.F. MUNRO SET POST

NO WITNESS: TREES CONVENIENT

ACCEPTED BY THE IOSCO COUNTY SURVEY PEER GROUP AS THE OFFICIAL CORNER UNDER P.A. 345 OF 1990 AT A MEETING HELD ON 10-31-95

*James H. Stranger*

B. Description of corner evidence found and/or method applied in restoring or reestablishing corner:


1992 SURVEY, J.F. OLIVER INDICATES FOUND CAMPBELL PIPE & CAP  
L. 223 P. 706  
NO WITNESSES  
ALSO 1972: JAMES G. CAMPBELL INDICATES 1/2" PIPE WITH CAP.

C. Description of monument for corner and accessories established to perpetuate locating the position of the corner:

1995 REMONUMENTATION, WILLIAM E. WOODS ACCEPT POSITION AS ESTABLISHED  
BY JAMES G. CAMPBELL #15397

- 6" JACK PINE S 165°E 48.70
- 6" JACK PINE S 120°E 52.67
- 6" JACK PINE N 15°E 45.58
- 6" JACK PINE S 25 °W 41.45

SET 5/8 BY 30" BAR WITH ALUMINUM REMONUMENTATION CAP

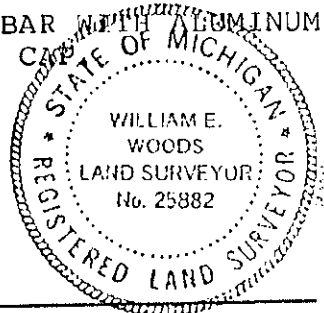

Signed by William E Woods  
Surveyor's Michigan License No. 25882

Date 12-8-95