

SURVEY & REMONUMENTATION

APR 27 1995

COMMISSION

REMONUMENTATION CORNER

LAND CORNER RECORDATION CERTIFICATE
Filing Requirement of Act 74, Mich. P.A. 1970

STATE OF MICHIGAN
IOSCO COUNTY
FILED

5 DEC 94 2:00 P.M.

BONITA N. COYLE
REGISTER OF DEEDS

94-31

Register of Deeds Stamp & File Number

For corners in
IOSCO

(County)

Located In:

Corner Code ##

- | | | | | |
|------------------------------------|---|------|----|-----|
| 1. Public Land Survey | T | 22NR | 9E | C-1 |
| | T | | R | |
| | T | | R | |
| | T | | R | |
| 2. Property Controlling in Section | S | | R | |
| | S | | R | |
| 3. Miscellaneous Property in Sec. | S | | R | |
| | S | | R | |

4. Lot No. _____, Recorded Plat _____
5. Private Claims _____

	A	B	C	D	E	F	G	H	I	J	K	L	M
2	6	5	4	3	2	1							
3													
4	7	8	9	10	11	12							
5													
6	18	17	16	15	14	13							
7													
8	19	20	21	22	23	24							
9													
10	30	29	28	27	26	25							
11													
12	31	32	33	34	35	36							
13													

I, John F. Oliver in a field survey on October 7, 1994, do hereby certify that under requirements of P.A. 74, Michigan P.A. of 1970, the corner points mentioned in lines 1 and 2 above were in conformance with regulations and rules therefore as required in the current manual of survey instructions of the United States Department of the Interior, Bureau of Land Management or by a decree of a Court of Law and/or that the corner points mentioned in lines 3, 4 and 5 above were in conformance with the rules of the Michigan Board of Land Surveyors or by a Decree of a Court of Law; established, re-established, monumented, re-monumented, recovered, found as expressed below:

NOTE: Not more than 4 corners, all in the same town and range, may be recorded on this certificate.

A. Description of original monument and accessories and/or subsequent restoration:

1843 Original Survey by J.F. Munro, set wood post
6" Spruce N24°W 64 links
6" Spruce N14°E 68 links

1979 Survey by R.L. Miller, corner not identified (Job No. 29-63-79)

1985 Survey by John F. Oliver, found concrete monument

B. Description of corner evidence found and/or method applied in restoring or reestablishing corner:

1994 Concrete Monument Not Found it was pulled out. We found hole and checked to traverse points, and re-set


ACCEPTED BY THE IOSCO COUNTY
SURVEY PEER GROUP AS THE
OFFICIAL CORNER UNDER P.A.
345 OF 1990 AT A MEETING
HELD ON 11-10-94

James A. Granger

C. Description of monument for corner and accessories established to perpetuate locating the position of the corner:

1" X 18" pipe with 1/2" X 18" pipe with 1/2" X 18" re-bar with aluminum cap

- 14" Red Pine S02°W 147.21
- 10" Red Pine S05°E 169.59
- 6" Jack Pine S22°E 173.52
- 10" Red Pine S64°W 179.75

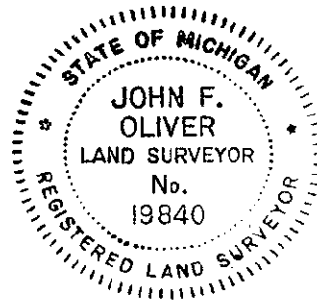

[Signature]

11-11-94

Signed by _____ Date _____
Surveyor's Michigan License No. 19840