

SURVEY & REMONUMENTATION

APR 27 1995

COMMISSION

REMONUMENTATION CORNER

LAND CORNER RECORDATION CERTIFICATE

Filing Requirement of Act 74, Mich. P.A. 1970

STATE OF MICHIGAN
IOSCO COUNTY
FILED

5 DEC 94 2:03 P.M.

BONITA H. COYLE
REGISTER OF DEEDS

94-49

Register of Deeds Stamp & File Number

For corners in

IOSCO
(County)

Located In:

Corner Code #

- | | | |
|------------------------------------|--------------------------|------------|
| 1. Public Land Survey | T <u>22N</u> R <u>9E</u> | <u>D-1</u> |
| | T _____ R _____ | _____ |
| | T _____ R _____ | _____ |
| | T _____ R _____ | _____ |
| 2. Property Controlling in Section | S _____ T _____ R _____ | _____ |
| | S _____ T _____ R _____ | _____ |
| 3. Miscellaneous Property in Sec. | S _____ T _____ R _____ | _____ |
| | S _____ T _____ R _____ | _____ |

4. Lot No. _____, Recorded Plat _____

5. Private Claims _____

	A	B	C	D	E	F	G	H	I	J	K	L	M
2	6	5	4	3	2	1							
3													
4	7	8	9	10	11	12							
5													
6	18	17	16	15	14	13							
7													
8	19	20	21	22	23	24							
9													
10	30	29	28	27	26	25							
11													
12	31	32	33	34	35	36							
13													

I, John F. Oliver in a field survey on September 12, 1994, do hereby certify that under requirements of P.A. 74, Michigan P.A. of 1970, the corner points mentioned in lines 1 and 2 above were in conformance with regulations and rules therefore as required in the current manual of survey instructions of the United States Department of the Interior, Bureau of Land Management or by a decree of a Court of Law and/or that the corner points mentioned in lines 3, 4 and 5 above were in conformance with the rules of the Michigan Board of Land Surveyors or by a Decree of a Court of Law; established, re-established, monumented, re-monumented, recovered, found as expressed below:

NOTE: Not more than 4 corners, all in the same town and range, may be recorded on this certificate.

A. Description of original monument and accessories and/or subsequent restoration:

- 1843 Original Survey, J.F. Munro, Set wood post
8" S. Pine N66°W 36 links
8" S. Pine N18°E 34 links
- 1979 Survey by Richard L. Miller, Not Described
- 1985 Survey by John F. Oliver, found Concrete Monument (Square)

B. Description of corner evidence found and/or method applied in restoring or reestablishing corner:

1994 Accept position of Concrete Monument (Square) set Aluminum cap on mon.


ACCEPTED BY THE IOSCO COUNTY SURVEY PEER GROUP AS THE OFFICIAL CORNER UNDER P.A. 345 OF 1990 AT A MEETING HELD ON 11-10-94

James H. Dranger

C. Description of monument for corner and accessories established to perpetuate locating the position of the corner:

Square concrete monument with aluminum cap

- 8" Oak N60°W 46.37
- 10" Oak S26°E 11.61
- 8" Oak S38°W 35.92
- 6" Red Pine S76°E 43.88

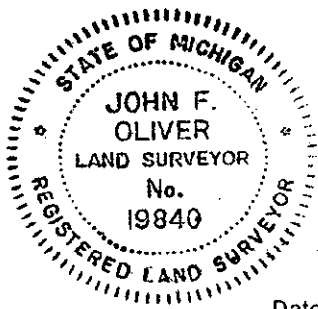

Signed by _____

Date 11-11-94

Surveyor's Michigan License No. 19840