

# SURVEY & REMONUMENTATION

APR 27 1995

## COMMISSION

### IOSCO COUNTY REMONUMENTATION CORNER LAND CORNER RECORDATION CERTIFICATE Filing Requirement of Act 74, Mich. P.A. 1970

STATE OF MICHIGAN  
IOSCO COUNTY  
FILED

5 DEC 94 2:02 P.M.

BONITA M. COYLE  
REGISTER OF DEEDS

# 94-46

Register of Deeds Stamp & File Number

For corners in

IOSCO  
(County)

Located In:

Corner Code #

- |                                    |                          |            |
|------------------------------------|--------------------------|------------|
| 1. Public Land Survey              | T <u>22N</u> R <u>9E</u> | <u>G-1</u> |
|                                    | T _____ R _____          | _____      |
|                                    | T _____ R _____          | _____      |
|                                    | T _____ R _____          | _____      |
| 2. Property Controlling in Section | S _____ T _____ R _____  | _____      |
|                                    | S _____ T _____ R _____  | _____      |
| 3. Miscellaneous Property in Sec.  | S _____ T _____ R _____  | _____      |
|                                    | S _____ T _____ R _____  | _____      |

4. Lot No. \_\_\_\_\_, Recorded Plat \_\_\_\_\_

5. Private Claims \_\_\_\_\_

	A	B	C	D	E	F	G	H	I	J	K	L	M
2	6		5		4		3		2		1		
3													
4	7		8		9		10		11		12		
5													
6	18		17		16		15		14		13		
7													
8	19		20		21		22		23		24		
9													
10	30		29		28		27		26		25		
11													
12	31		32		33		34		35		36		
13													

I, John F. Oliver in a field survey on September 12, 1994 do hereby certify that under requirements of P.A. 74, Michigan P.A. of 1970, the corner points mentioned in lines 1 and 2 above were in conformance with regulations and rules therefore as required in the current manual of survey instructions of the United States Department of the Interior, Bureau of Land Management or by a decree of a Court of Law and/or that the corner points mentioned in lines 3, 4 and 5 above were in conformance with the rules of the Michigan Board of Land Surveyors or by a Decree of a Court of Law; established, re-established, monumented, re-monumented, recovered, found as expressed below:

**NOTE: Not more than 4 corners, all in the same town and range, may be recorded on this certificate.**

A. Description of original monument and accessories and/or subsequent restoration:

1843 Original Survey, J.F. Munro Set wood post  
11" B. Oak N 38° W 45 lnks  
8" B. Oak N 4°30'E lnks  
1949 Subdivision, AuSable point beach No. 4 (L 5, P 44-47) indicates Concrete Mon at Corner position.

B. Description of corner evidence found and/or method applied in restoring or reestablishing corner:

1994 Accept position as established by Subdivision Found Square Concrete Mon.

ACCEPTED BY THE IOSCO COUNTY SURVEY PEER GROUP AS THE OFFICIAL CORNER UNDER P.A. 345 OF 1990 AT A MEETING HELD ON 11-10-94


*James H. Granger*

C. Description of monument for corner and accessories established to perpetuate locating the position of the corner:

Square Concrete Mon. with aluminum cap.

15" Oak S 63°E 27.40'  
Concrete Mon. S 78°W 70.23'  
10" White Pine S 62°W 19.34'  
15" White Pine S 36°W 11.95'

Located on S. edge of 25ft. wide pond

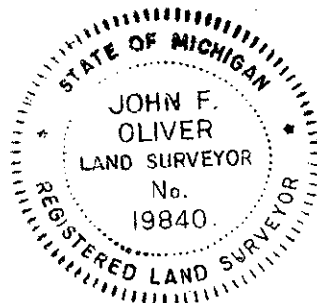

Signed by \_\_\_\_\_  
Surveyor's Michigan License No. 19840

Date 11-11-94