IOSCO COUNTY REMONUMENTATION

LAND CORNER RECORDATION CERTIFICATE

Filing Requirement of Act 74, Mich. P.A. 1970

95-30

For corners in

IOSCO (County)

	Located In:		Corner Code #
1. Public Land Survey		T22N R9E	C-3 to C-4 06
		T___ R___	
		T___ R___	
		T___ R___	
2. Property Controlling	S___	T___ R___	No. 6
in Section	S___	T___ R___	
3. Miscellaneous	S___	T___ R___	
Property in Sec.	S___	T___ R___	

STATE OF MICHIGAN
IOSCO COUNTY
FILED

12 DEC 95 2:29 P.M.

BONITA M. COYLE
REGISTER OF DEEDS

Register of Deeds Stamp & File Number

4. Lot No. _____, Recorded Plat _____

5. Private Claims _____

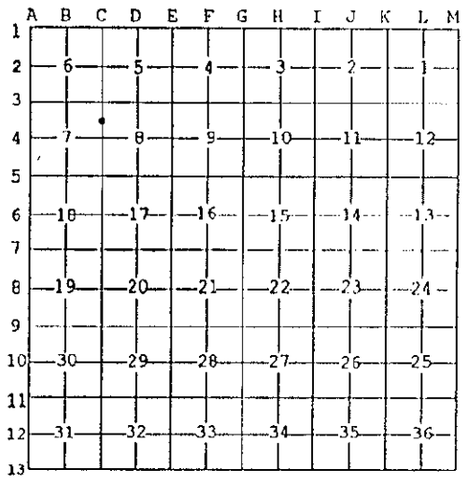

I, WILLIAM E. WOODS in a field survey on 11- 2 -, 19 95 do hereby state that under requirements of P.A. 74, Michigan P.A. of 1970, the corner points mentioned in lines 1 and 2 above were in conformance with regulations and rules therefore as required in the current manual of survey instructions of the United States Department of the Interior, Bureau of Land Management or by a decree of a Court of Law and /or that the corner points mentioned in lines 3, 4 and 5 above were in conformance with the rules of the Michigan Board of Land Surveyors or by a Decree of a Court of Law; established, re-established, monumented, recovered, found as expressed below:

NOTE: Not more than 2 corners, all in the same town and range, may be recorded on this certificate.

A. Description of original monument and accessories and/or subsequent restoration:

1843 ORIGINAL SURVEY, J.F. MUNRO SET POST
10" BLACK OAK N17°E 38LK
14" Y PINE N32°W 31LK

B. Description of corner evidence found and/or method applied in restoring or reestablishing corner:

1923 SUBDIVISION, JOHN W. APPLIN FIRST ADDITION TO HURON SHORE
SUBDIVISION SHOW"S CORNER TO BE S.E. CORNER LOT 16 L.1 P.39

ACCEPTED BY THE IOSCO COUNTY SURVEY PEER GROUP AS THE OFFICIAL CORNER UNDER P.A. 345 OF 1990 AT A MEETING HELD ON 10-31-95

James H Granger

C. Description of monument for corner and accessories established to perpetuate locating the position of the corner:

1995 REMONUMENTATION, WILLIAM E. WOODS WILL EXTEND SECTION LINE FROM NORTH USING C-2 & C-3

SET 5/8 X 30 RE-BAR WITH ALUMINUM CAP.
SPIKE EAST SIDE 18" WHITE PINE N50°E 19.67
FOUNDATION SE CORNER N60°W 19.68
SPIKE EAST SIDE 4" SPRUCE S53°W 22.68
SPIKE EAST SIDE 8" MAPLE N75°E 29.56

STATE OF MICHIGAN
WILLIAM E. WOODS
LAND SURVEYOR
No. 25882
REGISTERED LAND SURVEYOR

Signed by William E Woods Date 12-8-95

Surveyor's Michigan License No. 25882

FORM APPROVED BY MICHIGAN STATE BOARD OF PROFESSIONAL SURVEYORS, JAN. 28, 1971
REVISED MAY 14, 1975
REVISED JAN., 1983
REVISED OCT. 1995