

FEB 2 1996

IOSCO COUNTY REMONUMENTATION
LAND CORNER RECORDATION CERTIFICATE
Filing Requirement of Act 74, Mich. P.A. 1970

95-12

corners in

iosco (County)	Located In:	Corner Code #
<input checked="" type="checkbox"/> Public Land Survey	T23N R5E	F-5
<input type="checkbox"/> Property Controlling in Section	T R	
<input type="checkbox"/> Miscellaneous	T R	
<input type="checkbox"/> Property in Sec.	T R	
	S T R	
	S T R	
	S T R	
	S T R	

STATE OF MICHIGAN
IOSCO COUNTY
FILED

12 DEC 95 2:21 P.M.

RONITA H. COYLE
REGISTER OF DEEDS

Register of Deeds Stamp & File Number

Lot No. _____, Recorded Plat _____
Private Claims _____

James H. Granger, in a field survey on Nov. 7, 1995 do hereby state that under requirements of P.A. 74, Michigan P.A. of 1970, the corner points mentioned in lines 1 and 2 above were in conformance with regulations and rules therefore as required in the current manual of survey instructions of United States Department of the Interior, Bureau of Land Management or by a decree of a Court of Law for that the corner points mentioned in lines 3, 4 and 5 above were in conformance with the rules of the Michigan Board of Land Surveyors or by a Decree of a Court of Law; established, re-established, monumented, recovered, found as expressed below:

NOTE: Not more than 2 corners, all in the same town and range, may be recorded on this certificate.

	A	B	C	D	E	F	G	H	I	J	K	L	M
1													
2	6		5			4		3		2		1	
3													
4	7		8			9		10		11		12	
5													
6	18		17			16		15		14		13	
7													
8	19		20			21		22		23		24	
9													
10	30		29			28		27		26		25	
11													
12	31		32			33		34		35		36	
13													

Description of original monument and accessories and/or subsequent restoration:

Original Survey	Wood Post		
	10" Beech	N 29%°d E	18 lks.
	12" Hemlock	S 16%°d E	44 lks.

Description of corner evidence found and/or method applied in restoring or reestablishing corner:

Found 5/8" rebar in monument box. Corner position in 0.28' within single proportionate measurement and 0.21' off a straight line between NW and NE Sec. corners.


ACCEPTED BY THE IOSCO COUNTY SURVEY PEER GROUP AS THE OFFICIAL CORNER UNDER P.A. 345 OF 1990 AT A MEETING HELD ON 10-31-95

James H. Granger

Description of monument for corner and accessories established to perpetuate locating the position of the corner:

Existing 5/8" rebar with aluminum cap in monument box

14" apple	S 20%°d E	38.43' set nail and tag
Fence corner	South	33.22' set nail and tag
14" Maple	N 10%°d W	36.62' set nail and tag
36" Cottonwood	N 50%°d W	107.75' set nail and tag

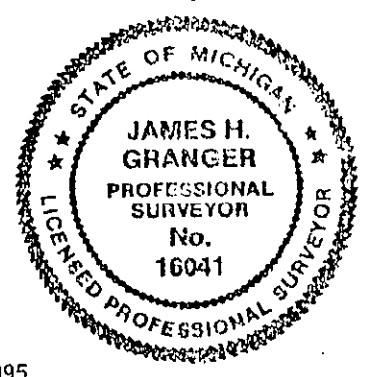

Surveyed by *James H. Granger*
Surveyor's Michigan License No. 16041

Date December 6, 1995