

FEB 2 1996

IOSCO COUNTY REMONUMENTATION  
LAND CORNER RECORDATION CERTIFICATE  
Filing Requirement of Act 74, Mich. P.A. 1970

95-13

For corners in

iosco (County)	Located In:	Corner Code #
1. Public Land Survey	T23N R 5E	G-5
	T ___ R ___	___
	T ___ R ___	___
	T ___ R ___	___
2. Property Controlling in Section	S ___ T ___ R ___	___
	S ___ T ___ R ___	___
3. Miscellaneous Property in Sec.	S ___ T ___ R ___	___
	S ___ T ___ R ___	___

STATE OF MICHIGAN  
IOSCO COUNTY  
FILED

12 DEC 95 2:21 P.M.

BONITA W. COYLE  
REGISTER OF DEEDS

Register of Deeds Stamp & File Number

4. Lot No. \_\_\_\_\_, Recorded Plat \_\_\_\_\_  
5. Private Claims \_\_\_\_\_

I, James H. Granger, in a field survey on Nov. 7, 1995 do hereby state that under requirements of P.A. 74, Michigan P.A. of 1970, the corner points mentioned in lines 1 and 2 above were in conformance with regulations and rules therefore as required in the current manual of survey instructions of the United States Department of the Interior, Bureau of Land Management or by a decree of a Court of Law and /or that the corner points mentioned in lines 3, 4 and 5 above were in conformance with the rules of the Michigan Board of Land Surveyors or by a Decree of a Court of Law; established, re-established, monumented, recovered, found as expressed below:

	A	B	C	D	E	F	G	H	I	J	K	L	M
1													
2	6		5		4		3		2		1		
3													
4	7		8		9		10		11		12		
5													
6	16		17		16		15		14		13		
7													
8	18		19		20		21		22		23		24
9													
10	30		28		28		27		26		25		
11													
12	31		32		33		34		35		36		
13													

NOTE: Not more than 2 corners, all in the same town and range, may be recorded on this certificate.

A. Description of original monument and accessories and/or subsequent restoration:

1844 Original Survey	Corner is 30" Yellow Pine
1973 Private Survey	1" pipe with 1/2" bolt
1989 Private Survey	1/2" iron with cap # 28417

B. Description of corner evidence found and/or method applied in restoring or reestablishing corner:

Found 1/2" iron and witnesses as previously established


ACCEPTED BY THE IOSCO COUNTY  
SURVEY PEER GROUP AS THE  
OFFICIAL CORNER UNDER P.A.  
345 OF 1990 AT A MEETING  
HELD ON 10-31-95

*James H. Granger*

-C. Description of monument for corner and accessories established to perpetuate locating the position of the corner:

5/8" x 30" Rebar with aluminum cap

P.P.	S 45% d E	77.82' existing nail
Wood Post	N 45% d W	42.30' existing nail
Fence Corner	S 60% d E	46.61' existing nail and tag #30101
P.P.	N 8% d W	215.26' existing R.R. spike

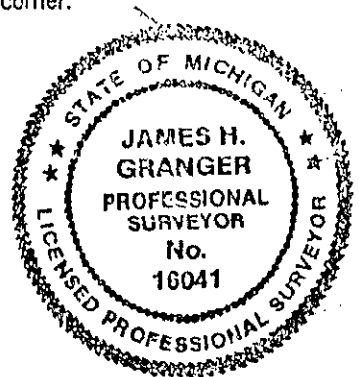

Signed by James H. Granger  
Surveyor's Michigan License No. 16041

Date December 6, 1995