

FEB 2 1996

IOSCO COUNTY REMONUMENTATION
LAND CORNER RECORDATION CERTIFICATE
Filing Requirement of Act 74, Mich. P.A. 1970

95-16

For corners in

<u>IOSCO</u> (County)	Located In:	Corner Code #
1. Public Land Survey	T23N R 5E	J-7
	T___ R___	_____
	T___ R___	_____
	T___ R___	_____
2. Property Controlling in Section	S___ T___ R___	_____
	S___ T___ R___	_____
3. Miscellaneous Property in Sec.	S___ T___ R___	_____
	S___ T___ R___	_____

STATE OF MICHIGAN
IOSCO COUNTY
FILED

12 DEC 95 2:22 P.M.

BONITA H. DOYLE
REGISTER OF DEEDS

Register of Deeds Stamp & File Number

4. Lot No. _____, Recorded Plat _____
5. Private Claims _____

I, James H. Granger, in a field survey on November 7, 1995 do hereby state that under requirements of P.A. 74, Michigan P.A. of 1970, the corner points mentioned in lines 1 and 2 above were in conformance with regulations and rules therefore as required in the current manual of survey instructions of the United States Department of the Interior, Bureau of Land Management or by a decree of a Court of Law and /or that the corner points mentioned in lines 3, 4 and 5 above were in conformance with the rules of the Michigan Board of Land Surveyors or by a Decree of a Court of Law; established, re-established, monumented, recovered, found as expressed below:

NOTE: Not more than 2 corners, all in the same town and range, may be recorded on this certificate.

A. Description of original monument and accessories and/or subsequent restoration:

1844 Original Survey	Wood Post 24" Hemlock 10" Birch	N1°E 74 lks. East 32 lks
1977 Private Survey	found 3/4" pipe	
1982 Private Survey	found 1" pipe	
1988 Private Survey	found 3/4" pipe	
1992 Private Survey		

B. Description of corner evidence found and/or method applied in restoring or reestablishing corner:

Found 3/4" pipe with 1/2" rebar and witness previously established.


ACCEPTED BY THE IOSCO COUNTY
SURVEY PEER GROUP AS THE
OFFICIAL CORNER UNDER P.A.
345 OF 1990 AT A MEETING
HELD ON 10-31-95

James H. Granger

C. Description of monument for corner and accessories established to perpetuate locating the position of the corner:

1/2" rebar inside 3/4" pipe with aluminium cap

PP	South	29.84'	ex. nail and tag #30101
20" Poplar	N65°E	88.10'	set nail and tag
36" Elm	N15°W	113.21'	set nail and tag
Wood Fence Post	S20°E	40.03'	set nail and tag

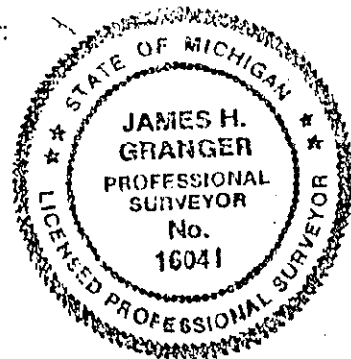

Signed by James H. Granger
Surveyor's Michigan License No. 16041

Date December 6, 1995