

FEB 2 1996

COMMISSION

IOSCO COUNTY REMONUMENTAION  
LAND CORNER RECORDATION CERTIFICATE  
Filing Requirement of Act 74, Mich. P.A. 1970

95-17

For corners in

iosco (County)	Located In:	Corner Code #
1. Public Land Survey	T23N R6E	C-9
	T___ R___	_____
	T___ R___	_____
	T___ R___	_____
2. Property Controlling in Section	S___ T___ R___	_____
	S___ T___ R___	_____
3. Miscellaneous Property in Sec.	S___ T___ R___	_____
	S___ T___ R___	_____

STATE OF MICHIGAN  
IOSCO COUNTY  
FILED

12 DEC 95 2:22 P.M.


PONITA M. COYLE  
REGISTER OF DEEDS

Registrar of Deeds Stamp & File Number

4. Lot No. \_\_\_\_\_, Recorded Plat \_\_\_\_\_  
5. Private Claims \_\_\_\_\_

James H. Granger, in a field survey on Nov. 3, 19\_\_ do hereby state that under requirements of P.A. 74, Michigan P.A. of 1970, the corner points mentioned in lines 1 and 2 above were in conformance with regulations and rules therefore as required in the current manual of survey instructions of the United States Department of the Interior, Bureau of Land Management or by a decree of a Court of Law and/or that the corner points mentioned in lines 3, 4 and 5 above were in conformance with the rules of the Michigan Board of Land Surveyors or by a Decree of a Court of Law; established, re-established, monumented, recovered, found as expressed below:

NOTE: Not more than 2 corners, all in the same town and range, may be recorded on this certificate.

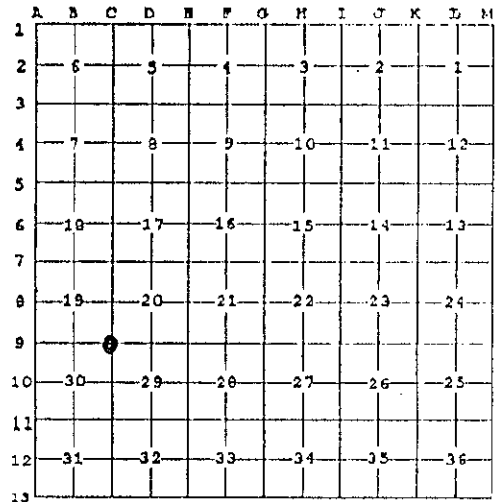

A. Description of original monument and accessories and/or subsequent restoration:

- 1844 Original Survey: Wood Post, 8" Spruce S 71%°d W 8 lks., 8" Spruce Pine N 73%°d E 32 lks.
- 1925 GLO Resurvey: 3' x 2" dia. iron post with brass cap
- 1973 Private Survey
- 1974 Private Survey
- 1977 Private survey: found concrete monument

B. Description of corner evidence found and/or method applied in restoring or reestablishing corner:


- Found 1/2" rebar in mon. box. Found previous witnesses to conc. mon. Witness fit existing 12" rebar.
- Found 22" stump: S 43%°d E 34.5'
- Found 16" stump: S 6%°d W 135.5'

ACCEPTED BY THE IOSCO COUNTY SURVEY PEER GROUP AS THE OFFICIAL CORNER UNDER P.A. 345 OF 1980 AT A MEETING HELD ON 10-31-95

*James H. Granger*

C. Description of monument for corner and accessories established to perpetuate locating the position of the corner:

- 5/8" x 30" Rebar with aluminum cap in monument box.
- Cedar post: South 33.00' Set nail and tag
- 20" White Pine: S 50%°d E 66.10' Set nail and tag
- 12" Jack Pine: N 35%°d E 80.23' Set nail and tag
- 4" x 4" Telephone Post: N 30%°d W 48.48' Set nail and tag

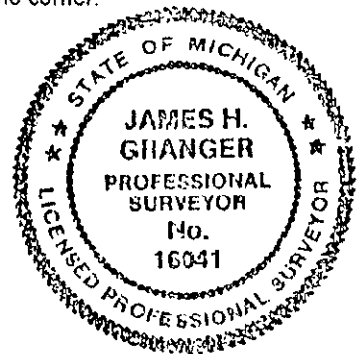

Signed by *James H. Granger*  
Surveyor's Michigan License No. 16041

Date December 6, 1995