

SURVEY & REMONUMENTATION

MAY 07 1997

COMMISSION

**IOSCO COUNTY REMONUMENTATION
LAND CORNER RECORDATION CERTIFICATE
Filing Requirement of Act 74, Mich. P.A. 1970**

96-78

For corners in

<u>IOSCO</u> (County)	Located In:	Corner Code #
1. Public Land Survey	<u>T23N R9E</u>	<u>A-3</u>
	T <u> </u> R <u> </u>	<u> </u>
	T <u> </u> R <u> </u>	<u> </u>
	T <u> </u> R <u> </u>	<u> </u>
2. Property Controlling in Section	S <u> </u> T <u> </u> R <u> </u>	<u> </u>
	S <u> </u> T <u> </u> R <u> </u>	<u> </u>
3. Miscellaneous Property in Sec.	S <u> </u> T <u> </u> R <u> </u>	<u> </u>
	S <u> </u> T <u> </u> R <u> </u>	<u> </u>

STATE OF MICHIGAN
IOSCO COUNTY
FILED

6 DEC 96 2:12 P.M.

BONITA H. COYLE
REGISTER OF DEEDS

Register of Deeds Stamp & File Number

4. Lot No. _____, Recorded Plat _____
5. Private Claims _____

I, WILLIAM E. WOODS in a field survey on NOV. 19, 1996 do hereby state that under requirements of P.A. 74, Michigan P.A. of 1970, the corner points mentioned in lines 1 and 2 above were in conformance with regulations and rules therefore as required in the current manual of survey instructions of the United States Department of the Interior, Bureau of Land Management or by a decree of a Court of Law and /or that the corner points mentioned in lines 3, 4 and 5 above were in conformance with the rules of the Michigan Board of Land Surveyors or by a Decree of a Court of Law, established, re-established, monumented, recovered, found as expressed below:

NOTE: Not more than 2 corners, all in the same town and range, may be recorded on this certificate.

	A	B	C	D	E	F	G	H	I	J	K	L	M
1													
2		6	5	4	3	2	1						
3													
4		7	8	9	10	11	12						
5													
6		18	17	16	15	14	13						
7													
8		19	20	21	22	23	24						
9													
10		30	29	28	27	26	25						
11													
12		31	32	33	34	35	36						
13													

A. Description of original monument and accessories and/or subsequent restoration:

1843: ORIGINAL GOVERNMENT SURVEY SET POST, 12" W. PINE S23°E, 23 LINKS
20" Balsa, N28°E, 28 LINKS

B. Description of corner evidence found and/or method applied in restoring or reestablishing corner:


1996: WILLIAM E. WOODS FOUND 1/2 BAR AT ROAD INTERSECTION
REPLACED 1/2 BAR WITH 5/8 ROD AND ALUMINUM CAP.

ACCEPTED BY THE IOSCO COUNTY SURVEY PEER GROUP AS THE OFFICIAL CORNER UNDER P.A. 345 OF 1990 AT A MEETING HELD ON 10-23-96

James H. Granger

C. Description of monument for corner and accessories established to perpetuate locating the position of the corner:

5/8 ROD AND ALUMINUM CAP.
5" JACKPINE S12°E 96.66
4x4 ORV SIGN POST S88°W 64.61
10" RED PINE N18°E 102.73
TWIN 12" OAKS N76°E 60.30

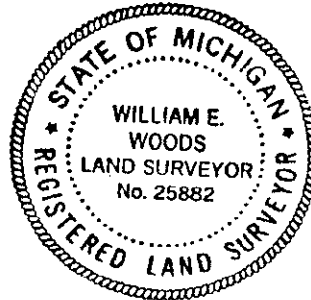

Signed by William E Woods

Date NOVEMBER 19, 1996

Surveyor's Michigan License No. 25882