

LAND CORNER RECORDATION CERTIFICATE

Filing Requirement of Act 74, Mich. P.A. 1970 IOSCO COUNTY REMONUMENTATION

For corners IOSCO Located In: _____ Corner Code # _____

1. Public Land Survey	T	<u>23</u>	R	<u>9</u>	<u>A-4</u>
	T	<u>23</u>	R	<u>9</u>	<u>M-4</u>
	T	_____	R	_____	_____
	T	_____	R	_____	_____
2. Property Controlling in Section	S	_____	T	_____	_____
	S	_____	T	_____	_____
3. Miscellaneous Property in Sec.	S	_____	T	_____	R
	S	_____	T	_____	R
4. Lot No. _____, Recorded Plat _____					
5. Private Claims _____					

STATE OF MICHIGAN
IOSCO COUNTY
FILED

21 NOV 97 1:06 P.M.

BONITA M. COYLE
REGISTER OF DEEDS

97-38

Register of Deeds Stamp & File Number

I, WILLIAM E. WOODS P.S., in a field survey on NOV. 17, 1997 do hereby state that under requirements of P.A. 74, Michigan P.A. of 1970, the corner points mentioned in lines 1 and 2 above were in conformance with regulations and rules therefore as required in the current manual of survey instructions of the United States Department of the Interior, Bureau of Land Management or by a decree of a Court of Law and /or that the corner points mentioned in lines 3, 4 and 5 above were in conformance with the rules of the Michigan Board of Land Surveyors or by a Decree of a Court of Law; established, re-established, monumented, recovered, found as expressed below:

NOTE: Not more than 2 corners, all in the same town and range, may be recorded on this certificate.

A. Description of original monument and accessories and/or subsequent restoration:

1843 ORIGINAL SURVEY	SET WOOD POST
J.F. MUNRO	Y. PINE 14" DIAM. S 22° W, 27 LINKS
	Y PINE N 57° W, 30 LINKS

ACCEPTED BY THE IOSCO COUNTY SURVEY PEER GROUP AS THE OFFICIAL CORNER UNDER P.A. 345 OF 1990 AT A MEETING HELD ON 9-16-97

James H. Chandler

B. Description of corner evidence found and/or method applied in restoring or reestablishing corner:

1997 REMONUMENTATION	NO EVIDENCE OF CORNER FOUND
WILLIAM E. WOODS	PROPOSE TO SET AT SINGLE PROPORTIONATE DISTANCE ON TOWNSHIP LINE


C. Description of monument for corner and accessories established to perpetuate locating the position of the corner:

SET 5/8 ROD AND REMON CAP MIDWAY AND ON LINE BETWEEN A-3 AND A-4

S 47° E 4.86' 10" POPLAR, SET NAIL AND TAG IN SMALL BLAZE
N 10° W 9.78' 12" POPLAR, SET NAIL AND TAG IN SMALL BLAZE
N 67° W 12.70' 4" JACK PINE, SET NAIL AND TAG IN SMALL BLAZE
S 62° W 11.22' 4" JACK PINE, SET NAIL AND TAG IN SMALL BLAZE

Signed by *William E Woods* Date 11-20-97
WILLIAM E. WOODS P.S.

Surveyor's Michigan License No. 25882

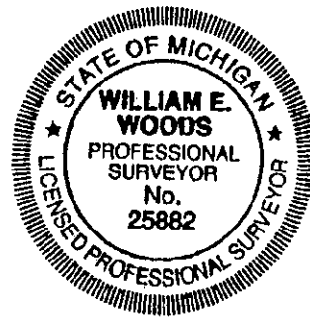

FORM APPROVED BY MICHIGAN STATE BOARD OF PROFESSIONAL SURVEYORS, JAN. 28, 1971
REVISED MAY 14, 1975
REVISED JAN., 1983

SURVEY & REMONUMENTATION

MAR 18 1998

SECTION