

**SURVEY & REMONUMENTATION**

MAY 07 1987

**COMMISSION**

**IOSCO COUNTY REMONUMENTATION  
LAND CORNER RECORDATION CERTIFICATE  
Filing Requirement of Act 74, Mich. P.A. 1970**

96-79

For corners in

<u>IOSCO</u> (County)	Located In:	Corner Code #
1. Public Land Survey	<u>T23N R9E</u>	<u>R-1</u>
	T___ R___	_____
	T___ R___	_____
	T___ R___	_____
2. Property Controlling in Section	S___ T___ R___	_____
	S___ T___ R___	_____
3. Miscellaneous Property in Sec.	S___ T___ R___	_____
	S___ T___ R___	_____

STATE OF MICHIGAN  
IOSCO COUNTY  
FILED  
6 DEC 96 2:12 P.M.  
RONITA M. COYLE  
REGISTER OF DEEDS  
Register of Deeds Stamp & File Number

4. Lot No. \_\_\_\_\_, Recorded Plat \_\_\_\_\_  
5. Private Claims \_\_\_\_\_

I, WILLIAM E. WOODS in a field survey on NOV. 19, 1996 do hereby state that under requirements of P.A. 74, Michigan P.A. of 1970, the corner points mentioned in lines 1 and 2 above were in conformance with regulations and rules therefore as required in the current manual of survey instructions of the United States Department of the Interior, Bureau of Land Management or by a decree of a Court of Law and/or that the corner points mentioned in lines 3, 4 and 5 above were in conformance with the rules of the Michigan Board of Land Surveyors or by a Decree of a Court of Law, established, re-established, monumented, recovered, found as expressed below:

NOTE: Not more than 2 corners, all in the same town and range, may be recorded on this certificate.

A	B	C	D	E	F	G	H	I	J	K	L	M
1	6	5	4	3	2	1						
2												
3												
4	7	8	9	10	11	12						
5												
6	18	17	16	15	14	13						
7												
8	19	20	21	22	23	24						
9												
10	30	29	28	27	26	25						
11												
12	31	32	33	34	35	36						
13												

A. Description of original monument and accessories and/or subsequent restoration:

NO ORIGINAL GOVERNMENT NOTES

1987: GOURDI/FRASER & ASSOCIATES

BOUNDARY SURVEY ON WURTSMITH AIR FORCE BASE SHOWS SOUTH 1/4 CORNER SECTION 32,

B. Description of corner evidence found and/or method applied in restoring or reestablishing corner:

1996: WILLIAM E. WOODS


SET N 1/4 CORNER OF SECTION 6 MIDWAY BETWEEN NE SECTION CORNER AND NW SECTION CORNER AT 17.3 FEET EAST OF FOUND SOUTH 1/4 CORNER OF SECTION 31. SET 5/8 ROD AND ALUMINUM CAP.

ACCEPTED BY THE IOSCO COUNTY SURVEY PEER GROUP AS THE OFFICIAL CORNER UNDER P.A. 345 OF 1990 AT A MEETING HELD ON 10-23-96

*James H. Grenger*

C. Description of monument for corner and accessories established to perpetuate locating the position of the corner:

5/8 ROD WITH ALUMINUM CAP  
MONUMENT BOX WITH 3/4 PIPE WEST 17.3 FEET  
3" JACKPINE S09°E 48.37  
8" OAK N31°W 54.07  
12" OAK N78°E 134.65  
(WADE TRIM WITNESS TAG)

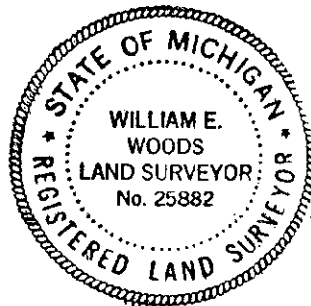

Signed by William E Woods  
Surveyor's Michigan License No. 25882

Date NOVEMBER 19, 1996