SURVEY &
REMONUMENTATION

MAY 07 1997

COMMISSION

96-77

STATE OF MICHIGAN
IOSCO COUNTY
FILED

6 DEC 96 2:12 P.M.

DONITA M. COYLE
REGISTER OF DEEDS

Register of Deeds Stamp & File Number

IOSCO COUNTY REMONUMENTATION

LAND CORNER RECORDATION CERTIFICATE

Filing Requirement of Act 74, Mich. P.A. 1970

For corners in IOSCO (County)

		Located In:	Corner Code ##
1. Public Land Survey		T 23N R 9E	C-3
		T ___ R ___	
		T ___ R ___	
		T ___ R ___	
2. Property Controlling	S ___	T ___ R ___	
in Section	S ___	T ___ R ___	
3. Miscellaneous	S ___	T ___ R ___	
Property in Sec.	S ___	T ___ R ___	

4. Lot No. _____, Recorded Plat _____
5. Private Claims _____

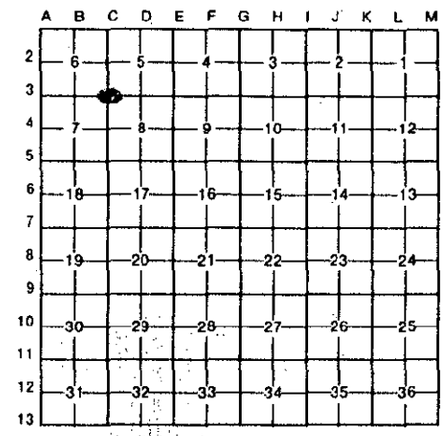

I, WILLIAM E. WOODS on a field survey on NOVEMBER 19, 19 96, do hereby certify that under requirements of P.A. 74, Michigan P.A. of 1970, the corner points mentioned in lines 1 and 2 above were in conformance with regulations and rules therefore as required in the current manual of survey instructions of the United States Department of the Interior, Bureau of Land Management or by a decree of a Court of Law and/or that the corner points mentioned in lines 3, 4 and 5 above were in conformance with the rules of the Michigan Board of Land Surveyors or by a Decree of a Court of Law; established, re-established, monumented, re-monumented, recovered, found as expressed below:

NOTE: Not more than 4 corners, all in the same town and range, may be recorded on this certificate.

A. Description of original monument and accessories and/or subsequent restoration:

1843: ORIGINAL GOVERNMENT SURVEY SET POST
10" W. PINE N01°E, 87 LINKS

B. Description of corner evidence found and/or method applied in restoring or reestablishing corner:

1996: WILLIAM E. WOODS

FOUND R.L. MILLER BAR AND CAP
146.68 EAST OF P.K. NAIL
THAT IS IN THE CENTERLINE OF
KENNEDY ROAD AND OLD U.S. 23.
REPLACED WITH 5/8 ROD AND ALUMINUM
CAP.

MEASURED FROM E-3 AND D-3,
PROVED CORNER TO BE WITHIN 0.60 FEET
OF DISTANCE BETWEEN D-3 AND E-3.

ACCEPTED BY THE IOSCO COUNTY
SURVEY PEER GROUP AS THE
OFFICIAL CORNER UNDER P.A.
345 OF 1990 AT A MEETING
HELD ON 10-23-96
James H Granger

C. Description of monument for corner and accessories established to perpetuate locating the position of the corner:

5/8 ROD WITH ALUMINUM CAP

8"	OAK	N28°E	35.24
6"	POPULAR	N25°W	44.51
4"	JACKPINE	S32°W	45.12
4"	JACKPINE	S02°E	41.01

STATE OF MICHIGAN
WILLIAM E. WOODS
LAND SURVEYOR
No. 25882
REGISTERED LAND SURVEYOR

Signed by William E Woods Date NOVEMBER 19, 1996

Surveyor's Michigan License No. 25882

FORM APPROVED BY MICHIGAN STATE BOARD OF LAND SURVEYORS, JAN. 28, 1971
REVISED MAY 14, 1975
REVISED JAN., 1983