LAND CORNER RECORDATION CERTIFICATE

Filing Requirement of Act 74, Mich. P.A. 1970

IOSCO COUNTY REMONUMENTATION

For corners IOSCO Located In: _____ Corner Code #

1. Public Land Survey T 23 R 9 D-3
   T ___ R ___
   T ___ R ___
   T ___ R ___
2. Property Controlling S ___ T ___ R ___
   in Section S ___ T ___ R ___
3. Miscellaneous S ___ T ___ R ___
   Property in Sec. S ___ T ___ R ___
4. Lot No. _____ , Recorded Plat _____
5. Private Claims _____

STATE OF MICHIGAN
IOSCO COUNTY
FILED

21 NOV 97 12:48 P.M.

BONITA M. COYLE
REGISTER OF DEEDS

97-30

Register of Deeds Stamp & File Number

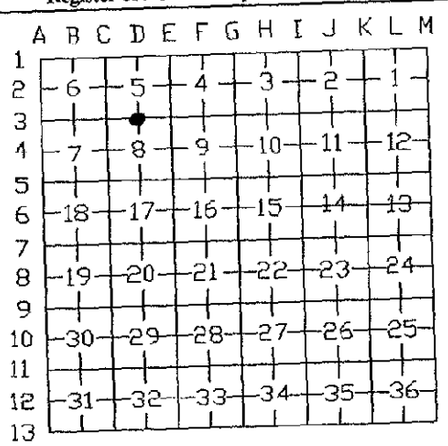

I, WILLIAM E. WOODS P.S. , in a field survey on NOV. 17 , 19 97 do hereby state that under requirements of P.A. 74, Michigan P.A. of 1970, the corner points mentioned in lines 1 and 2 above were in conformance with regulations and rules therefore as required in the current manual of survey instructions of the United States Department of the Interior, Bureau of Land Management or by a decree of a Court of Law and /or that the corner points mentioned in lines 3, 4 and 5 above were in conformance with the rules of the Michigan Board of Land Surveyors or by a Decree of a Court of Law; established, re-established, monumented, recovered, found as expressed below:

NOTE: Not more than 2 corners, all in the same town and range, may be recorded on this certificate.

A. Description of original monument and accessories and/or subsequent restoration:

1843 ORIGINAL SURVEY
J.F. MUNRO

SET WOOD POST
NO WITNESSES
39.87 CHAINS E OF SW CORNER SECTION 5, T23N, R5E

ACCEPTED BY THE IOSCO COUNTY SURVEY PEER GROUP AS THE OFFICIAL CORNER UNDER P.A. 345 OF 1990 AT A MEETING HELD ON 9-16-97
James H Granger

B. Description of corner evidence found and/or method applied in restoring or reestablishing corner:

FOUND 1/2" BAR AND R.L. MILLER CAP
FOUND 1/2" BAR IS 2633.61' E OF REMOND SW CORNER SEC. 5 (C-3)
AND 2634.25' W OF REOND SE CORNER SEC. 5 (E-3)
IT APPEARS THIS CORNER WAS INTENDED TO BE MIDWAY BUT IS 0.32' E OF MIDWAY
PROPOSE TO ACCEPT CORNER AT ESTABLISHED POSITION

1997 REMONUMENTATION
WILLIAM E. WOODS

C. Description of monument for corner and accessories established to perpetuate locating the position of the corne

FOUND 1/2" REROD WITH R. L. MILLER CAP, REPLACED WITH 5/8 ROD AND REMON CAP

N 36° W 55.09' TO 4" PINE, SET NAIL AND TAG NE SIDE
N 52° E 59.55' TO 14" PINE, SET NAIL AND TAG NE SIDE
S 15° E 49.92' TO 8" PINE, SET NAIL AND TAG SE SIDE
S 23° W 47.78' TO 6" PINE, SET NAIL AND TAG SE SIDE

STATE OF MICHIGAN
WILLIAM E. WOODS
PROFESSIONAL SURVEYOR
No. 25882
LICENSED PROFESSIONAL SURVEYOR

Signed by William E Woods Date 11-20-97
WILLIAM E. WOODS P.S.

Surveyor's Michigan License No. 25882

FORM APPROVED BY MICHIGAN STATE BOARD OF PROFESSIONAL SURVEYORS, JAN. 28, 1971
REVISED MAY 14,1975
REVISED JAN., 1983

SURVEY & REMONUMENTATION
MAR 18 1998
SECTION