

MAY 07 1997

COMMISSION

IOSCO COUNTY REMONUMENTATION
LAND CORNER RECORDATION CERTIFICATE
Filing Requirement of Act 74, Mich. P.A. 1970

For corners in

<u>IOSCO</u> (County)	Located In:	Corner Code #
1. Public Land Survey	T23NR9E	E-3
	T ___ R ___	___
	T ___ R ___	___
	T ___ R ___	___
2. Property Controlling in Section	S ___ T ___ R ___	___
	S ___ T ___ R ___	___
3. Miscellaneous Property In Sec.	S ___ T ___ R ___	___
	S ___ T ___ R ___	___
4. Lot No. _____, Recorded Plat _____		
5. Private Claims _____		

96-64

STATE OF MICHIGAN
IOSCO COUNTY
FILED

6 DEC 96 2:10 P.M.

Register of Deeds Stamp & File Number

HONITA H. COYLE
REGISTER OF DEEDS

	A	B	C	D	E	F	G	H	I	J	K	L	M
1													
2	6		5		4		3		2		1		
3													
4	7		8		9		10		11		12		
5													
6	18		17		16		15		14		13		
7													
8	19		20		21		22		23		24		
9													
10	30		29		28		27		26		25		
11													
12	31		32		33		34		35		36		
13													

I, WILLIAM E. WOODS in a field survey on NOV. 19, 1996 do hereby state that under requirements of P.A. 74, Michigan P.A. of 1970, the corner points mentioned in lines 1 and 2 above were in conformance with regulations and rules therefore as required in the current manual of survey instructions of the United States Department of the Interior, Bureau of Land Management or by a decree of a Court of Law and /or that the corner points mentioned in lines 3, 4 and 5 above were in conformance with the rules of the Michigan Board of Land Surveyors or by a Decree of a Court of Law; established, re-established, monumented, recovered, found as expressed below:

NOTE: Not more than 2 corners, all in the same town and range, may be recorded on this certificate.

A. Description of original monument and accessories and/or subsequent restoration:

1843: ORIGINAL GOVERNMENT NOTES

SET POST, 10" Y. PINE N01°E, 89 LINKS
NO OTHER TREES.

B. Description of corner evidence found and/or method applied in restoring or reestablishing corner:

1996: WILLIAM E. WOODS

FOUND 1" PIPE AT SECTION CORNER AS SHOWN ON MILLER SURVEY 176.5' EAST OF CENTERLINE OF GRASS LAKE ROAD TO THE NORTH AND APPROXIMATELY 15' EAST OF CENTERLINE OF THE ROAD SOUTH ACCEPT PIPE FOUND. SET 5/8 ROD AND ALUMINUM CAP.


ACCEPTED BY THE IOSCO COUNTY SURVEY PEER GROUP AS THE OFFICIAL CORNER UNDER P.A. 345 OF 1990 AT A MEETING HELD ON 10-23-96

James H. Grange

C. Description of monument for corner and accessories established to perpetuate locating the position of the corner:

- 5/8 ROD WITH ALUMINUM CAP
- 5" JACKPINE S10°E 90.68
- 6" JACKPINE S52°W 94.47
- 8" OAK N41°W 85.01
- 9" RED PINE N01°W 39.41

Signed by William E. Woods
Surveyor's Michigan License No. 25882

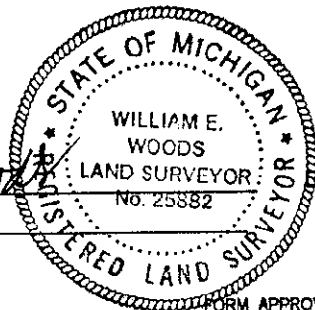

NOVEMBER 19, 1996