

IOSCO COUNTY REMONUMENTATION

LAND CORNER RECORDATION CERTIFICATE
Filing Requirement of Act 74, Mich. P.A. 1970

95-35

For corners in RESUBDIVISION

IOSCO Located In: Corner Code #
(County)

1. Public Land Survey T23NR9E F-1
T R
T R
T R

2. Property Controlling S T R
in Section S T R

3. Miscellaneous S T R
Property in Sec. S T R

STATE OF MICHIGAN
IOSCO COUNTY
FILED

12 DEC 95 2:30 P.M.

MORITA M. COYLE
REGISTER OF DEEDS

Register of Deeds Stamp & File Number

4. Lot No. _____, Recorded Plat _____
5. Private Claims _____

WILLIAM E. WOODS, in a field survey on 11-2-, 19 95 do hereby state that under requirements of P.A. 74, Michigan P.A. of 1970, the corner points mentioned in lines 1 and 2 above were in conformance with regulations and rules therefore as required in the current manual of survey instructions of the United States Department of the Interior, Bureau of Land Management or by a decree of a Court of Law and/or that the corner points mentioned in lines 3, 4 and 5 above were in conformance with the rules of the Michigan Board of Land Surveyors or by a Decree of a Court of Law, established, re-established, monumented, recovered, found as expressed below:

NOTE: Not more than 2 corners, all in the same town and range, may be recorded on this certificate.

	A	B	C	D	E	F	G	H	I	J	K	L	M
1													
2	6			5		4		3		2		1	
3													
4	7			8		9		10		11		12	
5													
6	18			17		16		15		14		13	
7													
8	19			20		21		22		23		24	
9													
10	30			29		28		27		26		25	
11													
12	31			32		33		34		35		36	
13													

A. Description of original monument and accessories and/or subsequent restoration:
1959: SUBDIVISION SUBDIVISION BOUNDARY DESCRIPTION COMMENCES AT
S.A. TOKOLY THIS CORNER

ACCEPTED BY THE IOSCO COUNTY
SURVEY PEER GROUP AS THE
OFFICIAL CORNER UNDER P.A.
345 OF 1990 AT A MEETING
HELD ON 10-31-95

James H. ...

B. Description of corner evidence found and/or method applied in restoring or reestablishing corner:

1995: REMONUMENTATION
WILLIAM E. WOODS


I MEASURED EAST & WEST OF THIS CORNER AND PRESENTED DISTANCES TO PEER GROUP. IT WAS DECIDED THAT PLAT USED 1/4 CORNER FOR SECTION TO NORTH FOR A COMMON CORNER FOR F-1 IN ERROR. SET 5/8" REROD FOR TRUE CORNER WITH ALUMINUM CAP MIDWAY BETWEEN NW. & NE SECTION CORNER 24.25' EAST OF FOUND 1/4 CORNER FOR SECTION TO NORTH.

C. Description of monument for corner and accessories established to perpetuate locating the position of the corner:

1995: REMONUMENTATION WILLIAM E. WOODS P.S. 25882

SET 5/8" REROD FOR TRUE CORNER

6" J.PINE N19°W 45.43
P.P. N65°E 46.78
8" R.PINE S24°E 56.19
P.P. S37°W 57.13

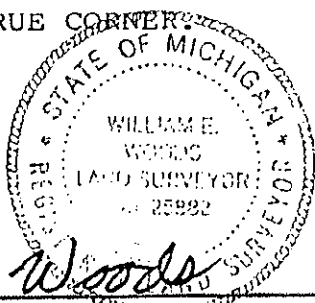

Signed by William E Woods
Surveyor's Michigan License No. 25882

Date 12-8-95