

MAY 17 1987

COMMISSIONER

IOSCO COUNTY REMONUMENTATION  
LAND CORNER RECORDATION CERTIFICATE  
Filing Requirement of Act 74, Mich. P.A. 1970

96-63

For corners in

IOSCO (County)	Located In:	Corner Code #
1. Public Land Survey	T23NR 9E	F-3
	T R	
	T R	
	T R	
2. Property Controlling in Section	S T R	
	S T R	
3. Miscellaneous Property in Sec.	S T R	
	S T R	

STATE OF MICHIGAN  
IOSCO COUNTY  
FILED

6 DEC 96 2:09 P.M.

BONITA M. COYLE  
REGISTER OF DEEDS

Register of Deeds Stamp & File Number

4. Lot No. \_\_\_\_\_, Recorded Plat \_\_\_\_\_  
5. Private Claims \_\_\_\_\_

I, WILLIAM E. WOODS, in a field survey on NOV. 19 19 96 do hereby state that under requirements of P.A. 74, Michigan P.A. of 1970, the corner points mentioned in lines 1 and 2 above were in conformance with regulations and rules therefore as required in the current manual of survey instructions of the United States Department of the Interior, Bureau of Land Management or by a decree of a Court of Law and /or that the corner points mentioned in lines 3, 4 and 5 above were in conformance with the rules of the Michigan Board of Land Surveyors or by a Decree of a Court of Law; established, re-established, monumented, recovered, found as expressed below:

NOTE: Not more than 2 corners, all in the same town and range, may be recorded on this certificate.

	A	B	C	D	E	F	G	H	I	J	K	L	M
1													
2	6	5			4		3		2				1
3													
4	7	8			9		10		11				12
5													
6	18	17			16		15		14				13
7													
8	19	20			21		22		23				24
9													
10	30	29			28		27		26				25
11													
12	31	32			33		34		35				36
13													

A. Description of original monument and accessories and/or subsequent restoration:

- 1843: ORIGINAL GOVERNMENT SURVEY SET POST, 14" W. PINE S02°W, 4 LINKS  
12" SPRUCE N80°E, 36 LINKS
- 1889: DANIEL GUILY PLAT: MOWAT ADDITION TO THE CITY OF  
AUSABLE RECORDED IN LIBER 2, PAGE 22.  
CORNER IS N.W. CORNER OF PLAT.  
OLIVER WOODS SUB. RECORDED LIBER 10  
PAGES 28 AND 29. PLAT COMMENCES AT  
THIS CORNER.
- 1961: R.J. COOK (AUG. !)
- 1980: R.L. MILLER PLAT: OSCODA-AUSABLE INDUSTRIAL PARK  
COMMENCES AT THIS CORNER.

B. Description of corner evidence found and/or method applied in restoring or reestablishing corner.


- 1996: WILLIAM E. WOODS FOUND 1" PIPE AT CORNER ON PLAT  
BOUNDARY TO NORTH.  
REPLACED 1" PIPE WITH 5/8" ROD AND  
ALUMINUM CAP.

ACCEPTED BY THE IOSCO COUNTY  
SURVEY PEER GROUP AS THE  
OFFICIAL CORNER UNDER P.A.  
345 OF 1990 AT A MEETING  
HELD ON 10-23-96

*James H. Kranger*

C. Description of monument for corner and accessories established to perpetuate locating the position of the corner:

- SET 5/8 ROD WITH ALUMINUM CAP IN MONUMENT BOX
- 6" JACKPINE S14°W 41.24
- 6" JACKPINE S52°W 42.46
- 10" JACKPINE N45°W 50.18
- 8" JACKPINE N21°W 45.05

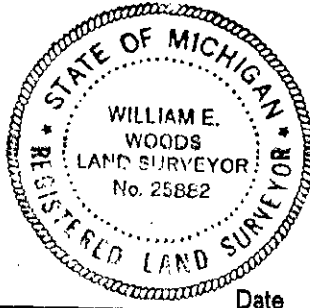

Signed by *William E. Woods*

Date NOVEMBER 19, 1996

Surveyor's Michigan License No. 25882