

LAND CORNER RECORDATION CERTIFICATE

Filing Requirement of Act 74, Mich. P.A. 1970

IOSCO COUNTY REMONUMENTATION

For corners IOSCO Located In: _____ Corner Code # _____

- | | | | | | | |
|---------------------------------------|---|-----------|---|----------|-------|-------|
| 1. Public Land Survey | T | <u>23</u> | R | <u>9</u> | F-7 | _____ |
| | T | _____ | R | _____ | _____ | _____ |
| | T | _____ | R | _____ | _____ | _____ |
| | T | _____ | R | _____ | _____ | _____ |
| 2. Property Controlling in Section | S | _____ | T | _____ | R | _____ |
| | S | _____ | T | _____ | R | _____ |
| 3. Miscellaneous Property in Sec. | S | _____ | T | _____ | R | _____ |
| | S | _____ | T | _____ | R | _____ |
| 4. Lot No. _____, Recorded Plat _____ | | | | | | |
| 5. Private Claims _____ | | | | | | |

STATE OF MICHIGAN
IOSCO COUNTY
FILED

21 NOV 97 1:03 P.M.

BONITA N. COYLE
REGISTER OF DEEDS

97-35

Register of Deeds Stamp & File Number

I, WILLIAM E. WOODS P.S., in a field survey on NOV. 17, 1997 do hereby state that under requirements of P.A. 74, Michigan P.A. of 1970, the corner points mentioned in lines 1 and 2 above were in conformance with regulations and rules therefore as required in the current manual of survey instructions of the United States Department of the Interior, Bureau of Land Management or by a decree of a Court of Law and /or that the corner points mentioned in lines 3, 4 and 5 above were in conformance with the rules of the Michigan Board of Land Surveyors or by a Decree of a Court of Law; established, re-established, monumented, recovered, found as expressed below:

	A	B	C	D	E	F	G	H	I	J	K	L	M
1													
2	6	5	4	3	2	1							
3													
4	7	8	9	10	11	12							
5													
6	18	17	16	15	14	13							
7													
8	19	20	21	22	23	24							
9													
10	30	29	28	27	26	25							
11													
12	31	32	33	34	35	36							
13													

NOTE: Not more than 2 corners, all in the same town and range, may be recorded on this certificate.

A. Description of original monument and accessories and/or subsequent restoration:

- | | |
|----------------------|--|
| 1843 ORIGINAL SURVEY | SET WOOD POST |
| J. F. MUMRO | Y. PINE 18" DIAM. BEARS S 81° E, 55 LINKS |
| | SPRUCE PINE 8" DIAM. BEARS N 38° W, 14 LINKS |

B. Description of corner evidence found and/or method applied in restoring or reestablishing corner:


- | | |
|----------------------------|---|
| 1971 JAMES CAMPBELL SURVEY | SURVEY LIBER 205, PAGE 423, INDICATED FOUND 1/2" ROD AT CORNER POSITION |
| | EAST 29.08', 6" JACK PINE |
| | SOUTH 26.91', 8" NORWAY PINE |
| 1997 REMONUMENTATION | FOUND 1/2" BAR AND CAP. ALSO FOUND 2 WITNESS 6" JACK PINE |
| | EAST 29.08' AND 8" NORWAY SOUTH 26.91' |

C. Description of monument for corner and accessories established to perpetuate locating the position of the corner:

FOUND 1/2" BAR AND CAP, REPLACED WITH 5/8 ROD AND REMON CAP

- POWER POLE N 03° E, 19.95'
- 8" OAK S 58° E, 10.92'
- 8" RED PINE S 15° W, 27.27'
- 16" RED PINE S 87° W, 6.55'

Signed by William E Woods Date 11-20-97
WILLIAM E. WOODS P.S.
Surveyor's Michigan License No. 25882

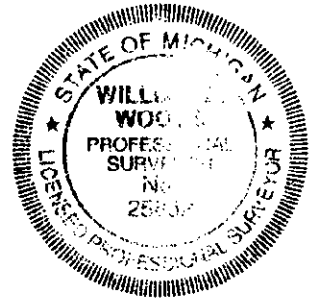

SURVEY & REMONUMENTATION

MAR 18 1998

SECTION

FORM APPROVED BY MICHIGAN STATE BOARD OF PROFESSIONAL SURVEYORS, JAN. 28, 1971
REVISED MAY 14, 1975
REVISED JAN., 1983