

**SURVEY &  
REMONUMENTATION**

MAY 07 1997

COMMISSION

For corners in

**IOSCO COUNTY REMONUMENTATION  
LAND CORNER RECORDATION CERTIFICATE  
Filing Requirement of Act 74, Mich. P.A. 1970**

**96-69**

<u>IOSCO</u> (County)	Located In:	Corner Code #
1. Public Land Survey	T23NR9E	G-2
	T ___ R ___	___
	T ___ R ___	___
	T ___ R ___	___
2. Property Controlling in Section	S ___ T ___ R ___	___
	S ___ T ___ R ___	___
3. Miscellaneous Property in Sec.	S ___ T ___ R ___	___
	S ___ T ___ R ___	___
4. Lot No. _____, Recorded Plat _____		
5. Private Claims _____		

STATE OF MICHIGAN  
IOSCO COUNTY  
FILED

6 DEC 96 2:11 P.M.

BONITA M. COYLE  
REGISTER OF DEEDS

Register of Deeds Stamp & File Number

I, WILLIAM E. WOODS, in a field survey on NOV. 19, 1996 do hereby state that under requirements of P.A. 74, Michigan P.A. of 1970, the corner points mentioned in lines 1 and 2 above were in conformance with regulations and rules therefore as required in the current manual of survey instructions of the United States Department of the Interior, Bureau of Land Management or by a decree of a Court of Law and /or that the corner points mentioned in lines 3, 4 and 5 above were in conformance with the rules of the Michigan Board of Land Surveyors or by a Decree of a Court of Law; established, re-established, monumented, recovered, found as expressed below:

NOTE: Not more than 2 corners, all in the same town and range, may be recorded on this certificate.

A	B	C	D	E	F	G	H	I	J	K	L	M
1												
2	6		5		4	●	3		2		1	
3												
4	7		8		9		10		11		12	
5												
6	18		17		16		15		14		13	
7												
8	19		20		21		22		23		24	
9												
10	30		29		28		27		26		25	
11												
12	31		32		33		34		35		36	
13												

A. Description of original monument and accessories and/or subsequent restoration:

1843: ORIGINAL GOVERNMENT SURVEY  
1961: R.J. COOKE

SET POST IN MARSH. NO TREES.  
PLAT CHIPPEWA LANDING. PLAT IN AREA  
OF THIS CORNER BUT USED S.W. SECTION  
CORNER INSTEAD.

B. Description of corner evidence found and/or method applied in restoring or reestablishing corner:

1996: WILLIAM E. WOODS


THIS CORNER RE-ESTABLISHED AT PROPORTIONATE DISTANCE BETWEEN G-3 AND THE NORTH LINE OF CHEVALIERS CLAIM.  
SET CORNER AT 2666.79 NORTH OF G-3.

ACCEPTED BY THE IOSCO COUNTY  
SURVEY PEER GROUP AS THE  
OFFICIAL CORNER UNDER P.A.  
345 OF 1990 AT A MEETING  
HELD ON 10-23-96

*James H. Kranger*

C. Description of monument for corner and accessories established to perpetuate locating the position of the corner:

5/8 ROD WITH ALUMINUM CAP  
8" POPLAR N59°E 14.72  
3" W. PINE S32°E 30.34  
4" POPLAR S73°W 15.95  
5" POPLAR N23°W 10.54

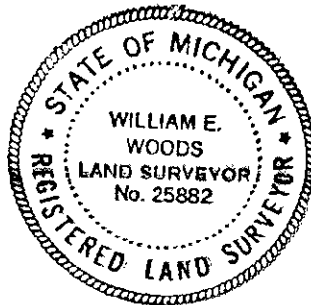

Signed by William E Woods  
Surveyor's Michigan License No. 25882

Date NOVEMBER 19, 1996