SURVEY &
REMONUMENTATION

APR 27 1995

COMMISSION

IOSCO COUNTY REMONUMENTATION CORNER
LAND CORNER RECORDATION CERTIFICATE
Filing Requirement of Act 74, Mich. P.A. 1970

STATE OF MICHIGAN
IOSCO COUNTY
FILED

5 DEC 94 2:03 P.M.

BONITA M. COYLE
REGISTER OF DEEDS

94-48

Register of Deeds Stamp & File Number

For corners in

IOSCO (County)

	Located In:	Corner Code ##
1. Public Land Survey	T 23N R 9E	G-5
	T ___ R ___	
	T ___ R ___	
	T ___ R ___	
2. Property Controlling	S ___ T ___ R ___	
in Section	S ___ T ___ R ___	
3. Miscellaneous	S ___ T ___ R ___	
Property in Sec.	S ___ T ___ R ___	

4. Lot No. _____ , Recorded Plat _____
5. Private Claims _____

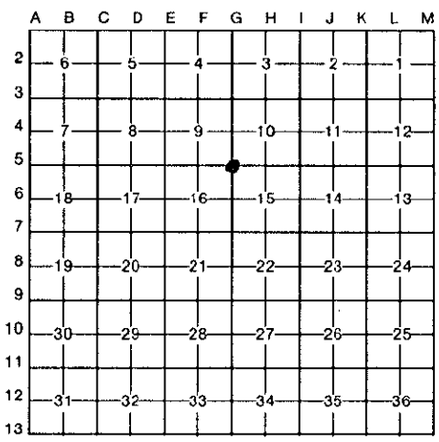

I, John F. Oliver in a field survey on October 3, 19 94, do hereby certify that under requirements of P.A. 74, Michigan P.A. of 1970, the corner points mentioned in lines 1 and 2 above were in conformance with regulations and rules therefore as required in the current manual of survey instructions of the United States Department of the Interior, Bureau of Land Management or by a decree of a Court of Law and/or that the corner points mentioned in lines 3, 4 and 5 above were in conformance with the rules of the Michigan Board of Land Surveyors or by a Decree of a Court of Law; established, re-established, monumented, re-monumented, recovered, found as expressed below:

NOTE: Not more than 4 corners, all in the same town and range, may be recorded on this certificate.

A. Description of original monument and accessories and/or subsequent restoration:

1844 Original Survey William Johnston Set Wood post
20" W. Pine S48°W 16 links
12" Birch N17°E 35 links

1959 Subdivision by R.J.Cooke "Brady's Big Pines No.1" L.9, P.11-12

B. Description of corner evidence found and/or method applied in restoring or reestablishing corner:

1994 Accept position as established by subdivision, Set pavement box with 5/8"X 30" re-rod with aluminum cap.

ACCEPTED BY THE IOSCO COUNTY SURVEY PEER GROUP AS THE OFFICIAL CORNER UNDER P.A. 345 OF 1990 AT A MEETING HELD ON 11-10-94
James H Granger

C. Description of monument for corner and accessories established to perpetuate locating the position of the corner:

5/8"X 30" re-rod with aluminum cap in pavement box.

Concrete monument N03°E 33.01
Twin 18" Red Pine S70°W 77.51
10" Maple N53°W 66.80
8" White Pine N56°E 51.77

STATE OF MICHIGAN
JOHN F. OLIVER
LAND SURVEYOR
No. 19840
REGISTERED LAND SURVEYOR

Signed by _____ Date 11-11-94

Surveyor's Michigan License No. 19840

FORM APPROVED BY MICHIGAN STATE BOARD OF LAND SURVEYORS, JAN. 28, 1971
REVISED MAY 14, 1975
REVISED JAN., 1983