

**SURVEY &
REMONUMENTATION**

APR 27 1995

COMMISSION

**IOSCO COUNTY REMONUMENTATION CORNER
LAND CORNER RECORDATION CERTIFICATE
Filing Requirement of Act 74, Mich. P.A. 1970**

STATE OF MICHIGAN
IOSCO COUNTY
FILED

5 DEC 94 2:01 P.M.

BONITA M. COYLE
REGISTER OF DEEDS

94-39

Register of Deeds Stamp & File Number

For corners in

Iosco

(County)

Located In:

Corner Code #

- | | | | | |
|---------------------------------------|---|-------------|------------|------------|
| 1. Public Land Survey | T | <u>23</u> N | <u>9</u> E | <u>G-6</u> |
| | T | ___ | R ___ | _____ |
| | T | ___ | R ___ | _____ |
| | T | ___ | R ___ | _____ |
| 2. Property Controlling
in Section | S | ___ | T ___ | R ___ |
| | S | ___ | T ___ | R ___ |
| 3. Miscellaneous
Property in Sec. | S | ___ | T ___ | R ___ |
| | S | ___ | T ___ | R ___ |

4. Lot No. _____, Recorded Plat _____
5. Private Claims _____

I, John F. Oliver in a field survey on October 3, 19 94, do hereby certify that under requirements of P.A. 74, Michigan P.A. of 1970, the corner points mentioned in lines 1 and 2 above were in conformance with regulations and rules therefore as required in the current manual of survey instructions of the United States Department of the Interior, Bureau of Land Management or by a decree of a Court of Law and/or that the corner points mentioned in lines 3, 4 and 5 above were in conformance with the rules of the Michigan Board of Land Surveyors or by a Decree of a Court of Law; established, re-established, monumented, re-monumented, recovered, found as expressed below:

NOTE: Not more than 4 corners, all in the same town and range, may be recorded on this certificate.

	A	B	C	D	E	F	G	H	I	J	K	L	M
2	6		5		4		3		2		1		
3													
4	7		8		9		10		11		12		
5													
6	18		17		16		15		14		13		
7													
8	19		20		21		22		23		24		
9													
10	30		29		28		27		26		25		
11													
12	31		32		33		34		35		36		
13													

A. Description of original monument and accessories and/or subsequent restoration:

1844 Original Survey by William Johnston, Set wood post
12" cedar N14°W 9 links
8" Cedar s31°E 16 links

1990 Subdivision Forest Heights (L.16, p 8) by R.L.Miller

B. Description of corner evidence found and/or method applied in restoring or reestablishing corner:

1994 Accept position as established by subdivision, found 3/4" bar,
Set 5/8"X 60" Bar with aluminum cap.


ACCEPTED BY THE IOSCO COUNTY
SURVEY PEER GROUP AS THE
OFFICIAL CORNER UNDER P.A.
345 OF 1990 AT A MEETING
HELD ON 11-10-94

James H. Stranger

C. Description of monument for corner and accessories established to perpetuate locating the position of the corner:

5/8"X 60" re-bar with aluminum cap, 15 ft. North of S. edge of Bayou

12" Oak S25°W 34.90
26" Maple S56°W 18.20
12" Birch S83°W 25.40
6" White Pine S06°E 31.85

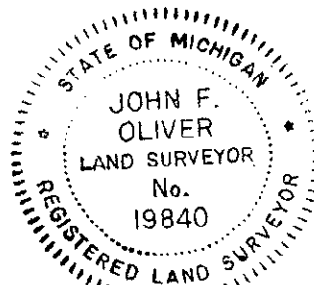

Signed by _____
Surveyor's Michigan License No. 19840

Date 11-11-94