

**SURVEY &  
REMONUMENTATION**

APR 27 1995

**COMMISSION**

**REMONUMENTATION CORNER  
LAND CORNER RECORDATION CERTIFICATE  
Filing Requirement of Act 74, Mich. P.A. 1970**

STATE OF MICHIGAN  
IOSCO COUNTY  
FILED

5 DEC 94 2:00 P.M.

BONITA H. COYLE  
REGISTER OF DEEDS

**94-34**

Register of Deeds Stamp & File Number

For corners in  
IOSCO  
(County)

Located in:	Corner Code #
1. Public Land Survey	T <u>23N</u> R <u>9E</u> <u>G-7</u>
	T _____ R _____
	T _____ R _____
	T _____ R _____
2. Property Controlling in Section	S _____ T _____ R _____
	S _____ T _____ R _____
3. Miscellaneous Property in Sec.	S _____ T _____ R _____
	S _____ T _____ R _____
4. Lot No. _____, Recorded Plat _____	
5. Private Claims _____	

A	B	C	D	E	F	G	H	I	J	K	L	M
2	6	5	4	3	2	1						
3												
4	7	8	9	10	11	12						
5												
6	18	17	16	15	14	13						
7												
8	19	20	21	22	23	24						
9												
10	30	29	28	27	26	25						
11												
12	31	32	33	34	35	36						
13												

I, John F. Oliver in a field survey on October 7, 19 94, do hereby certify that under requirements of P.A. 74, Michigan P.A. of 1970, the corner points mentioned in lines 1 and 2 above were in conformance with regulations and rules therefore as required in the current manual of survey instructions of the United States Department of the Interior, Bureau of Land Management or by a decree of a Court of Law and/or that the corner points mentioned in lines 3, 4 and 5 above were in conformance with the rules of the Michigan Board of Land Surveyors or by a Decree of a Court of Law; established, re-established, monumented, re-monumented, recovered, found as expressed below:

**NOTE: Not more than 4 corners, all in the same town and range, may be recorded on this certificate.**

A. Description of original monument and accessories and/or subsequent restoration:

1844 Original Survey by William Johnston, Set wood post  
8" Aspen N23°W 35 links  
8" Aspen S7°W 33 links

1956 Subdivision by R.J. Cooke, Supervisors Plat of Golden Beach No.1

B. Description of corner evidence found and/or method applied in restoring or reestablishing corner:

1994 Accept position as established by subdivision.  
Established Section line from old Survey records.  
Set 5/8"X 30" re-bar with aluminum cap witness monument on section line 529.23 ft. east of corner


ACCEPTED BY THE IOSCO COUNTY  
SURVEY PEER GROUP AS THE  
OFFICIAL CORNER UNDER P.A.  
345 OF 1990 AT A MEETING  
HELD ON 11-10-94

*James H. Cranger*

C. Description of monument for corner and accessories established to perpetuate locating the position of the corner:

5/8"X 30" re-bar with aluminum cap witness monument 529.23 ft. east of corner

- 12" red Pine s01°W 10.50
- 10" Red Pine S54°E 19.50
- 12" Red Pine N85°E 19.27
- 12" Red Pine N37°W 14.37

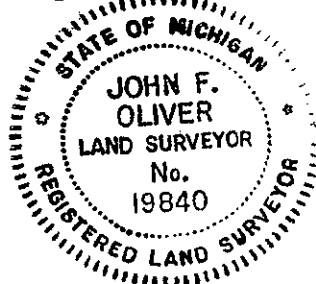

Signed by *[Signature]* Date 11-11-94  
Surveyor's Michigan License No. 19840