

**SURVEY &
REMONUMENTATION**

APR 27 1995

COMMISSION

IOSCO COUNTY REMONUMENTATION CORNER
LAND CORNER RECORDATION CERTIFICATE
Filing Requirement of Act 74, Mich. P.A. 1970

STATE OF MICHIGAN
IOSCO COUNTY
FILED

5 DEC 94 2:02 P.M.

BONITA M. COYLE
REGISTER OF DEEDS

94-45

Register of Deeds Stamp & File Number

For corners in
IOSCO
(County)

Located In: Corner Code #

1. Public Land Survey	T <u>23N</u> R <u>9E</u>	<u>G-10</u>
	T _____ R _____	_____
	T _____ R _____	_____
	T _____ R _____	_____
2. Property Controlling in Section	S _____ T _____ R _____	_____
	S _____ T _____ R _____	_____
3. Miscellaneous Property in Sec.	S _____ T _____ R _____	_____
	S _____ T _____ R _____	_____

4. Lot No. _____, Recorded Plat _____

5. Private Claims _____

	A	B	C	D	E	F	G	H	I	J	K	L	M
2	6	5	4	3	2	1							
3													
4	7	8	9	10	11	12							
5													
6	18	17	16	15	14	13							
7													
8	19	20	21	22	23	24							
9													
10	30	29	28	27	26	25							
11													
12	31	32	33	34	35	36							
13													

I, John F. Oliver in a field survey on October 3, 19 94, do hereby certify that under requirements of P.A. 74, Michigan P.A. of 1970, the corner points mentioned in lines 1 and 2 above were in conformance with regulations and rules therefore as required in the current manual of survey instructions of the United States Department of the Interior, Bureau of Land Management or by a decree of a Court of Law and/or that the corner points mentioned in lines 3, 4 and 5 above were in conformance with the rules of the Michigan Board of Land Surveyors or by a Decree of a Court of Law; established, re-established, monumented, re-monumented, recovered, found as expressed below:

NOTE: Not more than 4 corners, all in the same town and range, may be recorded on this certificate.

A. Description of original monument and accessories and/or subsequent restoration:

1844 Original Survey, William Johnston, set wood post
16" Tamarack S16°E 36 links
4" Tamarack N22°W 9 links

1977 Survey by John F. Oliver, 1/2" Bar and P.S.cap set by single proportion

B. Description of corner evidence found and/or method applied in restoring or reestablishing corner:

1994 found 1/2" bar and P.S.cap. Replaced with 5/8"X 30" re-bar & aluminum cap.


ACCEPTED BY THE IOSCO COUNTY
SURVEY PEER GROUP AS THE
OFFICIAL CORNER UNDER P.A.
345 OF 1990 AT A MEETING
HELD ON 11-10-94

James H. Chandler

C. Description of monument for corner and accessories established to perpetuate locating the position of the corner:

5/8"X 30" re-bar and aluminum cap

18" Red pine S19°W 16.38
Twin 15" & 18" Maple S51°E 35.30
28" Oak N78°W 37.16
10" White pine S75°W 16.63

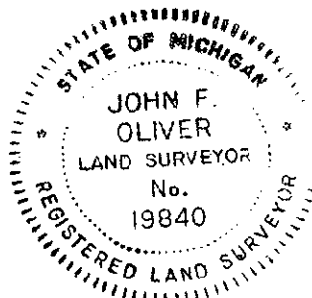

Signed by _____
Surveyor's Michigan License No. 19840

Date 11-11-94