

SURVEY & REMONUMENTATION

APR 27 1995

REMONUMENTATION CORNER

COMMISSION

LAND CORNER RECORDATION CERTIFICATE
Filing Requirement of Act 74, Mich. P.A. 1970

STATE OF MICHIGAN
IOSCO COUNTY
FILED

5 DEC 94 2:03 P.M.

BONITA H. COYLE
REGISTER OF DEEDS

94-51

Register of Deeds Stamp & File Number

For corners in

<u>IOSCO</u> (County)	Located In:	Corner Code #
	T <u>23N</u> R <u>9E</u>	<u>G-11</u>
	T _____ R _____	_____
	T _____ R _____	_____
	T _____ R _____	_____
1. Public Land Survey	S _____ T _____ R _____	_____
2. Property Controlling in Section	S _____ T _____ R _____	_____
3. Miscellaneous	S _____ T _____ R _____	_____
Property in Sec.	S _____ T _____ R _____	_____

4. Lot No. _____, Recorded Plat _____
5. Private Claims _____

I, John F. Oliver in a field survey on September 13, 19 94, do hereby certify that under requirements of P.A. 74, Michigan P.A. of 1970, the corner points mentioned in lines 1 and 2 above were in conformance with regulations and rules therefore as required in the current manual of survey instructions of the United States Department of the Interior, Bureau of Land Management or by a decree of a Court of Law and/or that the corner points mentioned in lines 3, 4 and 5 above were in conformance with the rules of the Michigan Board of Land Surveyors or by a Decree of a Court of Law; established, re-established, monumented, re-monumented, recovered, found as expressed below:

NOTE: Not more than 4 corners, all in the same town and range, may be recorded on this certificate.

A	B	C	D	E	F	G	H	I	J	K	L	M
2	6	5	4	3	2	1						
3												
4	7	8	9	10	11	12						
5												
6	18	17	16	15	14	13						
7												
8	19	20	21	22	23	24						
9												
10	30	29	28	27	26	25						
11												
12	31	32	33	34	35	36						
13												

A. Description of original monument and accessories and/or subsequent restoration:
1844 Original Survey William Johnston, set wood post
6" Cedar N72°E 17 links
12" Cedar S35°W 13 links

1942 Subdivision, AuSable Point Beach No. 1 (L. 4, P 19-20) indicates Concrete monument at location.

B. Description of corner evidence found and/or method applied in restoring or reestablishing corner:

1994 accept position as established by subdivision, found broken concrete monument laying near corner. reestablished position of corner from subdivision data.
Set 5/8" X 6 foot re-bar with aluminum cap.


ACCEPTED BY THE IOSCO COUNTY SURVEY PEER GROUP AS THE OFFICIAL CORNER UNDER P.A. 345 OF 1990 AT A MEETING HELD ON 11-10-94

James H. Krueger

C. Description of monument for corner and accessories established to perpetuate locating the position of the corner:

5/8" X 6 foot re-bar with aluminum cap

18" White Pine N67°W 51.00
Twin 8"& 3" Hemlock N40°E 47.66
Triple 6"& 10"& 12" Maple S60°E 19.62
14" Cedar South 30.20

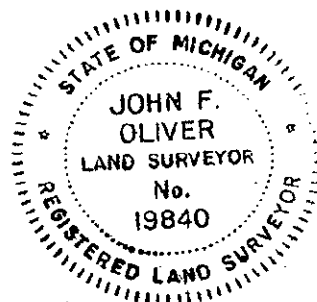

Signed by _____ Date 11-11-94
Surveyor's Michigan License No. 19840