

MAY 07 1997

COMMISSION

IOSCO COUNTY REMONUMENTATION LAND CORNER RECORDATION CERTIFICATE

STATE OF MICHIGAN IOSCO COUNTY FILED

96-66

6 DEC 96 2:10 P.M.

BONITA M. COYLE REGISTER OF DEEDS

For corners in

Table with columns: IOSCO (County), Located In: (Town/Range), Corner Code #. Rows include Public Land Survey, Property Controlling in Section, Miscellaneous Property in Sec., Lot No., and Private Claims.

Register of Deeds Stamp & File Number

Grid table with columns A-M and rows 2-13. Cell (2,8) contains a small circle.

I, WILLIAM E. WOODS, in a field survey on NOVEMBER 19, 1996, do hereby certify that under requirements of P.A. 74, Michigan P.A. of 1970, the corner points mentioned in lines 1 and 2 above were in conformance with regulations and rules therefor as required in the current manual of survey instructions of the United States Department of the Interior, Bureau of Land Management or by a decree of a Court of Law and/or that the corner points mentioned in lines 3, 4 and 5 above were in conformance with the rules of the Michigan Board of Land Surveyors or by a Decree of a Court of Law, established, re-established, monumented, re-monumented, recovered, found as expressed below:

NOTE: Not more than 4 corners, all in the same town and range, may be recorded on this certificate.

A. Description of original monument and accessories and/or subsequent restoration:

- 1843: ORIGINAL GOVERNMENT SURVEY 40.0 SET POST 16" Y. PINE N 41 1/2° W. 84 LINKS. 12" Y. PINE S 16° W 52 LINKS
1868: A. BRAKEMUDE SHOWS THIS CORNER ON LOT 1, BLOCK 1 OF VILLAGE OF OSCODA.
1953: RAYMOND T. KING PLAT: HULL ISLAND SUB. COMMENCES AT THIS CORNER.

NOTE: 1961 & 1962 MERRIL V. HUNTER PLAT: HULL ISLAND SUB., #1, and #2.

B. Description of corner evidence found and/or method applied in restoring or reestablishing corner:


- 1996: WILLIAM E. WOODS FOUND 1/2 BAR AND R.L. MILLER CAP, HE SAID HE SET FROM RECORDED PLATS DATA. REPLACED 1/2 BAR WITH 5/8 ROD, WITH ALUMINUM CAP.

ACCEPTED BY THE IOSCO COUNTY SURVEY PEER GROUP AS THE OFFICIAL CORNER UNDER P.A. 345 OF 1990 AT A MEETING HELD ON 10-23-96

James H. Sawyer (Signature)

C. Description of monument for corner and accessories established to perpetuate locating the position of the corner:

- CENTER OF BELL SYSTEM MANHOLE COVER SET 5/8 BAR AND ALUMINUM CAP N74°W 13.06 P.P. S36°W 60.54
SOUTHWEST CORNER OF COMMERCIAL BLDG. 510 P.P. N02°E 139.34 N75°E 122.38

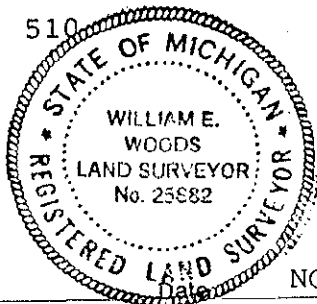

Signed by William E. Woods (Signature) Surveyor's Michigan License No. 25882

NOVEMBER 19, 1996