

**SURVEY &  
REMONUMENTATION**

APR 27 1995

**COMMISSION**

**REMONUMENTATION CORNER  
LAND CORNER RECORDATION CERTIFICATE  
Filing Requirement of Act 74, Mich. P.A. 1970**

STATE OF MICHIGAN  
IOSCO COUNTY  
FILED

For corners in

<u>IOSCO</u> (County)	Located In:	Corner Code #
1. Public Land Survey	T <u>23N</u> R <u>9E</u>	<u>H-5</u>
	T _____ R _____	_____
	T _____ R _____	_____
	T _____ R _____	_____
2. Property Controlling in Section	S _____ T _____ R _____	_____
	S _____ T _____ R _____	_____
3. Miscellaneous Property in Sec.	S _____ T _____ R _____	_____
	S _____ T _____ R _____	_____

5 DEC 94 2:00 P.M.

BONITA H. COYLE  
REGISTER OF DEEDS

**94-33**

Register of Deeds Stamp & File Number

4. Lot No. \_\_\_\_\_, Recorded Plat \_\_\_\_\_  
5. Private Claims \_\_\_\_\_

I, Iosco, in a field survey on September 13, 19 94, do hereby certify that under requirements of P.A. 74, Michigan P.A. of 1970, the corner points mentioned in lines 1 and 2 above were in conformance with regulations and rules therefore as required in the current manual of survey instructions of the United States Department of the Interior, Bureau of Land Management or by a decree of a Court of Law and/or that the corner points mentioned in lines 3, 4 and 5 above were in conformance with the rules of the Michigan Board of Land Surveyors or by a Decree of a Court of Law; established, re-established, monumented, re-monumented, recovered, found as expressed below:

**NOTE: Not more than 4 corners, all in the same town and range, may be recorded on this certificate.**

A. Description of original monument and accessories and/or subsequent restoration:

1844 Original Survey by William Johnston set wood post  
10" S Pine S49°W 45 links  
6" S pine N1°E 38 links

1980 Subdivision, Assessor's Plat of Caldwell Acres (L.15, P.47-48) indicates corner as point of beginning. by R.L.Miller

B. Description of corner evidence found and/or method applied in restoring or reestablishing corner:

1994 Subdivision, Assessor's Plat of Caldwell Acres (L.15, P.47-48)


1994 Accept position as established by subdivision found Concrete Monument

ACCEPTED BY THE IOSCO COUNTY  
SURVEY PEER GROUP AS THE  
OFFICIAL CORNER UNDER P.A.  
345 OF 1990 AT A MEETING  
HELD ON 11-10-94

*James H. Kranger*

C. Description of monument for corner and accessories established to perpetuate locating the position of the corner:

Concrete Monument with Aluminum Cap  
20" Maple S80°W 9.03  
16" White Pine N18°W 36.80  
8" Red Oak East 19.30  
8" White pine N50°E 47.23

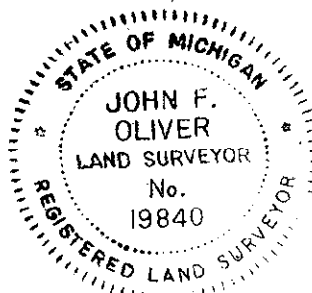

Signed by [Signature]  
Surveyor's Michigan License No. 19840

Date 11-11-94