

IOSCO COUNTY REMONUMENTATION CORNER (2000)

FEB 15 2001

**LAND CORNER RECORDATION CERTIFICATE  
Filing Requirement of Act 74, Mich. P.A. 1970**

SECTION \_\_\_\_\_

For corners in IOSCO Located In: \_\_\_\_\_ Corner Code # \_\_\_\_\_

1. Public Land Survey      T 24N R 9E      B-1 ✓  
                                   T 25N R 9E      B-13 ALCONA  
                                   T \_\_\_\_\_ R \_\_\_\_\_  
                                   T \_\_\_\_\_ R \_\_\_\_\_  
                                   T \_\_\_\_\_ R \_\_\_\_\_

2. Property Controlling      S \_\_\_\_\_  
 in Section                    S \_\_\_\_\_  
                                   T \_\_\_\_\_ R \_\_\_\_\_  
                                   T \_\_\_\_\_ R \_\_\_\_\_

3. Miscellaneous            S \_\_\_\_\_  
 Property in Sec.            \_\_\_\_\_

4. Lot No. \_\_\_\_\_, Recorded Plat \_\_\_\_\_

5. Private Claims \_\_\_\_\_

059 2000

STATE OF MICHIGAN  
IOSCO COUNTY  
FILED  
15 DEC 2000 2:24:42 PM  
BONITA M. COYLE  
REGISTER OF DEEDS

Register of Deeds Stamp & File Number

	A	B	C	D	E	F	G	H	I	J	K	L	M
1													
2	6	5	4	3	2	1							
3													
4	7	8	9	10	11	12							
5													
6	18	17	16	15	14	13							
7													
8	19	20	21	22	23	24							
9													
10	30	29	28	27	26	25							
11													
12	31	32	33	34	35	36							
13													

I, WILLIAM E. WOODS P.S. ; in a field survey on OCT. 16, 2000 do hereby state that under requirements of P.A. 74, Michigan P.A. of 1970, the corner points mentioned in lines 1 and 2 above were in conformance with regulations and rules therefore as required in the current manual of survey instructions of the United States Department of the Interior, Bureau of Land Management or by a decree of a Court of Law and /or that the corner points mentioned in lines 3, 4 and 5 above were in conformance with the rules of the Michigan Board of Land Surveyors or by a Decree of a Court of Law; established, re-established, monumented, recovered, found as expressed below:

NOTE: Not more than 2 corners, all in the same town and range, may be recorded on this certificate.

A. Description of original monument and accessories and/or subsequent restoration:

NO GOVERNEMENT NOTES FOR THIS CORNER

ACCEPTED BY THE IOSCO COUNTY SURVEY PEER GROUP AS THE OFFICIAL CORNER UNDER P.A. 345 OF 1990 AT A MEETING HELD ON 10-11-2000

*James H. Chappin*


B. Description of corner evidence found and/or method applied in restoring or reestablishing corner:

1975: JOHN F. OLIVER  
 1979: R.L. MILLER  
 1994: WILLIAM E. WOODS  
 2000: WILLIAM E. WOODS

NORTH 1/4 CORNER OF SECTION 6 SHOWS HE FOUND 1/2" IRON PIPE  
 NORTH 1/4 CORNER OF SECTION 6 SHOWS POINT OF BEGINNING OF MARTIN ACRES SUB.  
 NORTH 1/4 CORNER SHOWS HE FOUND RAILROAD SPIKE  
 FOUND 1/2" BAR IN MONUMENT BOX ON LINE WITH CORNERS A-1 & C-1 AT 2625.62 FEET EAST OF A-1 AND 2622.00 FEET WEST OF C-1 ACCEPTED AS B-1 REPLACED WITH 5/8" REROD & REMON CAP  
 ALSO FOUND 1/2" BAR IN MONUMENT BOX WEST 20.68 FEET OF ACCEPTED B-1 NOT ACCEPTED AS GOVERNMENT CORNER

C. Description of monument for corner and accessories established to perpetuate locating the position of the corner:  
 5/8" REROD WITH REMON CAP

OAK 6" N28°W 46.11' NAIL & TAG  
 JACK PINE 5" N12°E 48.17' NAIL & TAG  
 POPLAR 6" S26°W 44.15' NAIL & TAG  
 JACK PINE 10" S43°W 46.56' NAIL & TAG  
 20.68' WEST 1/2" IRON ROD IN MONUMENT BOX (NOT ACCEPTED AT GOVERNMENT CORNER)

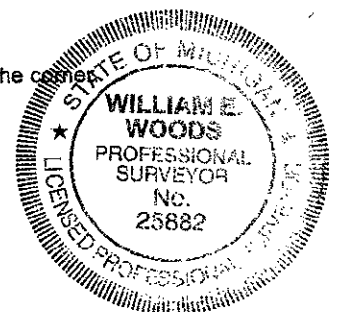

Signed by William E Woods

Date 12-06-2000

WILLIAM E. WOODS P.S.

Surveyor's Michigan License No. 25882