

LAND CORNER RECORDATION CERTIFICATE REMONUMENTATION
Filing Requirement of Act 74, Mich. P.A. 1970

SURVEY &
FEB 15 2001

For corners in IOSCO Located In: Corner Code #

- 1. Public Land Survey T 24N R 9E E-5
2. Property Controlling in Section S T R
3. Miscellaneous Property in Sec. S
4. Lot No. Recorded Plat

5. Private Claims

I, WILLIAM E. WOODS P.S., in a field survey on OCT. 16, 20 00 do hereby state that under requirements of P.A. 74, Michigan P.A. of 1970, the corner points mentioned in lines 1 and 2 above were in conformance with regulations and rules therefore as required in the current manual of survey instructions of the United States Department of the Interior, Bureau of Land Management or by a decree of a Court of Law and /or that the corner points mentioned in lines 3, 4 and 5 above were in conformance with the rules of the Michigan Board of Land Surveyors or by a Decree of a Court of Law; established, re-established, monumented, recovered, found as expressed below:

NOTE: Not more than 2 corners, all in the same town and range, may be recorded on this certificate.

A. Description of original monument and accessories and/or subsequent restoration:

1843: ORIGINAL GOVERNMENT NOTES

SET POST
Y. PINE 16" S57°E 33 LKS.
SPR. PINE 8" N37°E 60 LKS.

ACCEPTED BY THE IOSCO COUNTY SURVEY PEER GROUP AS THE OFFICIAL CORNER UNDER P.A. 345 OF 1990 AT A MEETING HELD ON 10-11-2000

James H. [Signature]

B. Description of corner evidence found and/or method applied in restoring or reestablishing corner:

1921: R.J. COOKE

PLAT SHOWS SECTION LINE SECTIONS 8 & 9 FROM 1/4 CORNER SOUTH SURVEY SHOWS POINT OF BEGINNING AT THIS CORNER AND ALSO SHOWS S.W. OF SECTION 9, 86.07 FEET EAST OF NORTHWEST CORNER OF SECTION 16, AND SHOWS THAT SURVEY COMMENCES AT THIS CORNER SURVEY DONE BY N.E.L.S. SHOWS BOTH SECTION CORNERS, SURVEY SHOWS THEY FOUND CONCRETE MONUMENT AT SOUTHEAST CORNER OF SECTION 8

1999 & 2000: WILLIAM E. WOODS

PEER GROUP ACCEPTED 3/4" PIPE TO THE WEST

2000: WILLIAM E. WOODS (REMON)

C. Description of monument for corner and accessories established to perpetuate locating the position of the corner:

5/8" BAR & REMON CAP INSIDE OF A 3/4" PIPE

- OAK 6" N38°E 14.13' NAIL & TAG
W. PINE 4" N12°W 27.47' NAIL & TAG
OAK 12" S80°W 14.78' NAIL & TAG
W. PINE 4" S17°W 34.09' NAIL & TAG
CONCRETE MONUMENT EAST 86.07'




Signed by William E Woods

Date 12-06-2000

WILLIAM E. WOODS P.S.

Surveyor's Michigan License No. 25882

Register of Deeds Stamp & File Number
Grid with columns A-M and rows 1-13. A dot is marked at row 5, column F.

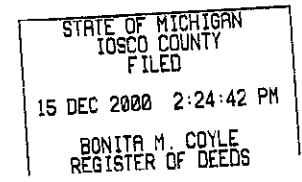

067 2000

SECTION