

LAND CORNER RECORDATION CERTIFICATE

Filing Requirement of Act 74, Mich. P.A. 1970


FEB 15 2001

SECTION

For corners in IOSCO Located In: _____ Corner Code # _____

- 1. Public Land Survey T 24N R 9E F-1
- T _____ R _____
- T _____ R _____
- T _____ R _____
- T _____ R _____
- 2. Property Controlling S _____
- in Section S _____
- T _____ R _____
- S _____ T _____ R _____
- 3. Miscellaneous S _____
- Property in Sec. S _____
- _____
- 4. Lot No. _____ , Recorded Plat _____

063 2000

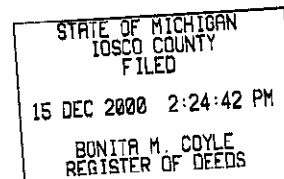

Register of Deeds Stamp & File Number

	A	B	C	D	E	F	G	H	I	J	K	L	M
1													
2	6	5	4	3	2	1							
3													
4	7	8	9	10	11	12							
5													
6	18	17	16	15	14	13							
7													
8	19	20	21	22	23	24							
9													
10	30	29	28	27	26	25							
11													
12	31	32	33	34	35	36							
13													

I, WILLIAM E. WOODS P.S., in a field survey on OCT. 16, 2000 do hereby state that under requirements of P.A. 74, Michigan P.A. of 1970, the corner points mentioned in lines 1 and 2 above were in conformance with regulations and rules therefore as required in the current manual of survey instructions of the United States Department of the Interior, Bureau of Land Management or by a decree of a Court of Law and /or that the corner points mentioned in lines 3, 4 and 5 above were in conformance with the rules of the Michigan Board of Land Surveyors or by a Decree of a Court of Law; established, re-established, monumented, recovered, found as expressed below:


NOTE: Not more than 2 corners, all in the same town and range, may be recorded on this certificate.

A. Description of original monument and accessories and/or subsequent restoration:

NO GOVERNMENT NOTES

ACCEPTED BY THE IOSCO COUNTY SURVEY PEER GROUP AS THE OFFICIAL CORNER UNDER P.A. 345 OF 1990 AT A MEETING HELD ON 10-11-2000

James H. Sawyer

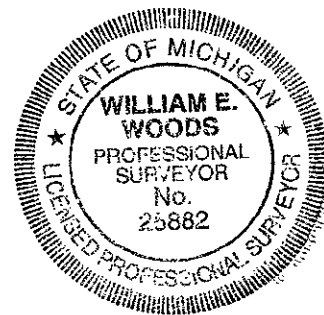

B. Description of corner evidence found and/or method applied in restoring or reestablishing corner:

1992: JOHN OLIVER

NORTH 1/4 CORNER OF SECTION 4 SHOWS THEY FOUND A MONUMENT BOX

2000: WILLIAM E. WOODS

FOUND 1" BOLT IN MONUMENT BOX 32.01' WEST OF F-13 T25N R9E AS SHOWN ON 1992 OLIVER SURVEY

C. Description of monument for corner and accessories established to perpetuate locating the position of the corner:

ROUND STEEL POST 4" N10°W 43.56'
P.P. N52°E 55.18'
P.P. S44°E 60.44'
OAK 4" S29°W 39.22'
F-13 T25N R9E R.R. SPIKE EAST 32.01'

REPLACED 1" BOLT WITH 5/8" KEROD AND REMON CAP

Signed by

William E Woods

Date

12-06-2000

WILLIAM E. WOODS P.S.

Surveyor's Michigan License No. 25882