

LAND CORNER RECORDATION CERTIFICATE
Filing Requirement of Act 74, Mich. P.A. 1970

SURVEY & REMONUMENTATION


FEB 15 2001

SECTION

For corners in IOSCO Located in: _____ Corner Code # _____

1. Public Land Survey	T	<u>24N</u>	R	<u>9E</u>	<u>F-5</u>
	T	_____	R	_____	_____
	T	_____	R	_____	_____
	T	_____	R	_____	_____
	T	_____	R	_____	_____
	T	_____	R	_____	_____
2. Property Controlling in Section	S	_____	R	_____	_____
	S	_____	R	_____	_____
	T	_____	R	_____	_____
	T	_____	R	_____	_____
3. Miscellaneous Property in Sec.	S	_____	R	_____	_____
	S	_____	R	_____	_____

068 2000

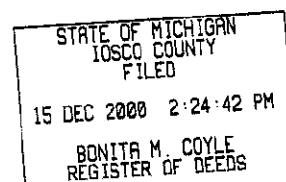

Register of Deeds Stamp & File Number

5. Private Claims _____

I, WILLIAM E. WOODS P.S., in a field survey on OCT 16, 2000 do hereby state that under requirements of P.A. 74, Michigan P.A. of 1970, the corner points mentioned in lines 1 and 2 above were in conformance with regulations and rules therefore as required in the current manual of survey instructions of the United States Department of the Interior, Bureau of Land Management or by a decree of a Court of Law and /or that the corner points mentioned in lines 3, 4 and 5 above were in conformance with the rules of the Michigan Board of Land Surveyors or by a Decree of a Court of Law; established, re-established, monumented, recovered, found as expressed below:

	A	B	C	D	E	F	G	H	I	J	K	L	M
1													
2	6	5	4	3	2	1							
3													
4	7	8	9	10	11	12							
5													
6	18	17	16	15	14	13							
7													
8	19	20	21	22	23	24							
9													
10	30	29	28	27	26	25							
11													
12	31	32	33	34	35	36							
13													

NOTE: Not more than 2 corners, all in the same town and range, may be recorded on this certificate.

A. Description of original monument and accessories and/or subsequent restoration:

1843: ORIGINAL GOVERNMENT NOTES

SET POST
 SPR. PINE 10" N70°E 26 LKS
 SPR. PINE 7" S29°W 08 LKS

ACCEPTED BY THE IOSCO COUNTY SURVEY PEER GROUP AS THE OFFICIAL CORNER UNDER P.A. 345 OF 1990 AT A MEETING HELD ON 10-11-2000

B. Description of corner evidence found and/or method applied in restoring or reestablishing corner:


James H. Stranger

- 1999: WILLIAM E. WOODS SURVEY DONE BY NORTHEAST LAND SURVEYS SHOWS THEY FOUND 3/4" PIPE
- 2000: WILLIAM E. WOODS SURVEY DONE BY NORTHEAST LAND SURVEYS SHOWS THEY FOUND 3/4" PIPE
- 2000" WILLIAM E. WOODS (REMON) FOUND 3/4" PIPE SHOWN ON TWO PREVIOUS SURVEYS, REPLACED WITH 5/8" REROD & REMON ALUMINUM CAP

C. Description of monument for corner and accessories established to perpetuate locating the position of the corner:

5/8" REROD WITH REMON CAP

- OAK 10" S46°W 26.80'
- OAK 4" N15°W 29.54'
- J. PINE 6" S79°E 26.42'
- J. PINE 6" N27°E 17.03'

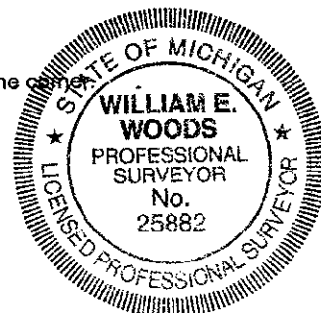

Signed by William E Woods

Date 12-6-2000

WILLIAM E. WOODS P.S.

Surveyor's Michigan License No. 25882