

**LAND CORNER RECORDATION CERTIFICATE**  
**Filing Requirement of Act 74, Mich. P.A. 1970**

1999 IOSCO COUNTY REMONUMENTATION CORNER

For corners IOSCO Located in: \_\_\_\_\_ Corner Code # \_\_\_\_\_

1. Public Land Survey T 24N R 9E G-1  
 T \_\_\_\_\_ R \_\_\_\_\_  
 T \_\_\_\_\_ R \_\_\_\_\_  
 T \_\_\_\_\_ R \_\_\_\_\_

2. Property Controlling in Section S \_\_\_\_\_ T \_\_\_\_\_ R \_\_\_\_\_  
 S \_\_\_\_\_ T \_\_\_\_\_ R \_\_\_\_\_

3. Miscellaneous Property in Sec. S \_\_\_\_\_ T \_\_\_\_\_ R \_\_\_\_\_  
 S \_\_\_\_\_ T \_\_\_\_\_ R \_\_\_\_\_

4. Lot No. \_\_\_\_\_, Recorded Plat \_\_\_\_\_

5. Private Claims \_\_\_\_\_

99-65

STATE OF MICHIGAN  
 IOSCO COUNTY  
 FILED

22 DEC 99 2:41 P.M.

SONITA N. CIVIL  
 REGISTERED CLERK

Register of Deeds Stamp & File Number

I, WILLIAM E. WOODS P.S., in a field survey on DEC. 10, 1999 do hereby state that under requirements of P.A. 74, Michigan P.A. of 1970, the corner points mentioned in lines 1 and 2 above were in conformance with regulations and rules therefore as required in the current manual of survey instructions of the United States Department of the Interior, Bureau of Land Management or by a decree of a Court of Law and/or that the corner points mentioned in lines 3, 4 and 5 above were in conformance with the rules of the Michigan Board of Land Surveyors or by a Decree of a Court of Law; established, re-established, monumented, recovered, found as expressed below:

	A	B	C	D	E	F	G	H	I	J	K	L	M
1													
2	6	5	4	3	2	1							
3													
4	7	8	9	10	11	12							
5													
6	18	17	16	15	14	13							
7													
8	19	20	21	22	23	24							
9													
10	30	29	28	27	26	25							
11													
12	31	32	33	34	35	36							
13													

**NOTE:** Not more than 2 corners, all in the same town and range, may be recorded on this certificate.

**A. Description of original monument and accessories and/or subsequent restoration:**

1843: ORIGINAL GOVERNMENT NOTES

SET POST

TAMARACK 7° N23°W 19 LKS

TAMARACK 10° N18°E 19 LKS

1970: R.L. MILLER

LAKESIDE SHORES GOLF & COUNTRY CLUB


PLAT COMMENCES AT THIS CORNER

LIBER 13 PAGES 23-27

**B. Description of corner evidence found and/or method applied in restoring or reestablishing corner:**

SET CORNER ON COUNTY LINE AT MEAN DISTANCE OF PLAT CALLS WHICH IS 71.34 FEET WEST OF I-13 T25N, 9RE  
 LAKEWOOD SHORES GOLF & COUNTRY CLUB PLAT CALL FALLS 71.65 FEET WEST OF I-13 T25N, 9RE  
 SOUTH CEDAR LAKE SUBDIVISION NO. 1 PLAT CALL FALLS 71.03 FEET WEST OF I-13 T25N, 9RE GOVERNMENT CALLS 10 LINKS WEST OF I-13 T25N, 9RE

ACCEPTED BY THE IOSCO COUNTY  
 SURVEY PEER GROUP AS THE  
 OFFICIAL CORNER UNDER P.A.  
 345 OF 1990 AT A MEETING  
 HELD ON 12-13-99

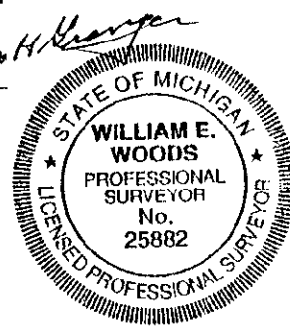

**C. Description of monument for corner and accessories established to perpetuate locating the position of the corner:**

SET 5/8" BAR & REMON CAP IN PAVEMENT BOX

EAST 71.34' RAILROAD SPIKES

SET NAIL & TAG N26°W 31.56' TWIN 8" ASH

SET NAIL & TAG N27°E 32.90' 8" COTTONWOOD

SET NAIL & TAG S70°W 108.37' POWER POLE

Signed by William E. Woods Date 12-15-99

WILLIAM E. WOODS P.S.

Surveyor's Michigan License No. 25882

FORM APPROVED BY MICHIGAN STATE  
 BOARD OF PROFESSIONAL SURVEYORS, JAN. 28, 1971  
 REVISED MAY 14, 1975  
 REVISED JAN., 1983

REF

APR 27 2000

SECTION