LAND CORNER RECORDATION CERTIFICATE
Filing Requirement of Act 74, Mich. P.A. 1970

1999 IOSCO COUNTY REMONUMENTATION CORNER

For corners IOSCO Located by _____ Corner Code # _____

1. Public Land Survey T 24N R 9E G-6
   T ___ R ___ ___
   T ___ R ___ ___
   T ___ R ___ ___
2. Property Controlling S ___ T ___ R ___ ___
   in Section S ___ T ___ R ___ ___
3. Miscellaneous S ___ T ___ R ___ ___
   Property in Sec. S ___ T ___ R ___ ___
4. Lot No. _____ , Recorded Plat _____
5. Private Claims _____

99- 60

STATE OF MICHIGAN
IOSCO COUNTY
FILED

22 DEC 99 2:38 P.M.

DONITA M. COALE
REGISTER OF DEEDS

Register of Deeds Stamp & File Number

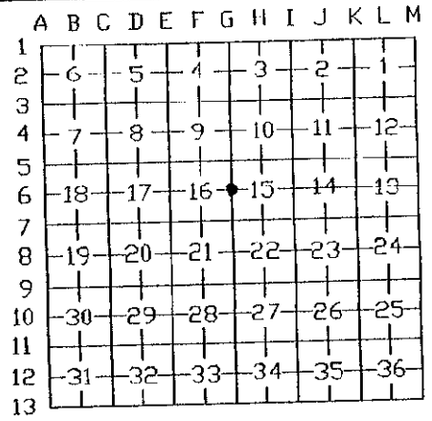

I, WILLIAM E. WOODS P.S. , in a field survey on DEC. 10 , 1999 do hereby state that under requirements of P.A. 74, Michigan P.A. of 1970, the corner points mentioned in lines 1 and 2 above were in conformance with regulations and rules therefore as required in the current manual of survey instructions of the United States Department of the Interior, Bureau of Land Management or by a decree of a Court of Law and /or that the corner points mentioned in lines 3, 4 and 5 above were in conformance with the rules of the Michigan Board of Land Surveyors or by a Decree of a Court of Law; established, re-established, monumented, recovered, found as expressed below:

NOTE: Not more than 2 corners, all in the same town and range, may be recorded on this certificate.

A. Description of original monument and accessories and/or subsequent restoration:

1843: ORIGINAL GOVERNMENT NOTES

SET POST
YELLOW PINE 22" N81°E 33 LKS
MAPLE 8" S11°E 28 LKS

B. Description of corner evidence found and/or method applied in restoring or reestablishing corner:

SET CORNER MIDWAY AND ON LINE WITH SECTION CORNERS

ACCEPTED BY THE IOSCO COUNTY SURVEY PEER GROUP AS THE OFFICIAL CORNER UNDER P.A. 345 OF 1990 AT A MEETING HELD ON 10-13-99
James H Granger

STATE OF MICHIGAN
WILLIAM E. WOODS
PROFESSIONAL SURVEYOR
No. 25882
LICENSED PROFESSIONAL SURVEYOR

C. Description of monument for corner and accessories established to perpetuate locating the position of the corner:

SET 5/8" BAR & REMON CAP

SET NAIL & TAG N8°W 20.30' 24" W. PINE
SET NAIL & TAG N75°E 62.80' 12" R. PINE
SET NAIL & TAG S60°E 71.69' 6" R. PINE
SET NAIL & TAG N37°W 40.56' 18" OAK

Signed by William E Woods Date 12-15-99
WILLIAM E. WOODS P.S.
Surveyor's Michigan License No. 25882

FORM APPROVED BY MICHIGAN STATE BOARD OF PROFESSIONAL SURVEYORS, JAN. 28, 1971
REVISED MAY 14,1975
REVISED JAN., 1983

RFR

APR 4 2000

SECTION