

REMONUMENTATION

FEB 16 1999

# LAND CORNER RECORDATION CERTIFICATE

## Filing Requirement of Act 74, Mich. P.A. 1970

REMONUMENTATION CORNER

For corners IOSCO Located In: \_\_\_\_\_ Corner Code # \_\_\_\_\_

1. Public Land Survey T 24N R 9E H-7  
 T \_\_\_\_\_ R \_\_\_\_\_  
 T \_\_\_\_\_ R \_\_\_\_\_  
 T \_\_\_\_\_ R \_\_\_\_\_

2. Property Controlling S \_\_\_\_\_ T \_\_\_\_\_ R \_\_\_\_\_  
 in Section S \_\_\_\_\_ T \_\_\_\_\_ R \_\_\_\_\_

3. Miscellaneous S \_\_\_\_\_ T \_\_\_\_\_ R \_\_\_\_\_  
 Property in Sec. S \_\_\_\_\_ T \_\_\_\_\_ R \_\_\_\_\_

4. Lot No. \_\_\_\_\_, Recorded Plat \_\_\_\_\_

5. Private Claims \_\_\_\_\_

# 98-61

STATE OF MICHIGAN  
IOSCO COUNTY  
FILED

10 DEC 98 2:57 P.M.

RONITA M. COYLE  
REGISTER OF DEEDS

Register of Deeds Stamp & File Number

I, WILLIAM E. WOODS P.S., in a field survey on NOV 17, 1998 do hereby state that under requirements of P.A. 74, Michigan P.A. of 1970, the corner points mentioned in lines 1 and 2 above were in conformance with regulations and rules therefore as required in the current manual of survey instructions of the United States Department of the Interior, Bureau of Land Management or by a decree of a Court of Law and/or that the corner points mentioned in lines 3, 4 and 5 above were in conformance with the rules of the Michigan Board of Land Surveyors or by a Decree of a Court of Law; established, re-established, monumented, recovered, found as expressed below:

|    | A  | B  | C  | D  | E  | F  | G | H | I | J | K | L | M |
|----|----|----|----|----|----|----|---|---|---|---|---|---|---|
| 1  |    |    |    |    |    |    |   |   |   |   |   |   |   |
| 2  | 6  | 5  | 4  | 3  | 2  | 1  |   |   |   |   |   |   |   |
| 3  |    |    |    |    |    |    |   |   |   |   |   |   |   |
| 4  | 7  | 8  | 9  | 10 | 11 | 12 |   |   |   |   |   |   |   |
| 5  |    |    |    |    |    |    |   |   |   |   |   |   |   |
| 6  | 18 | 17 | 16 | 15 | 14 | 13 |   |   |   |   |   |   |   |
| 7  |    |    |    |    |    |    |   |   |   |   |   |   |   |
| 8  | 19 | 20 | 21 | 22 | 23 | 24 |   |   |   |   |   |   |   |
| 9  |    |    |    |    |    |    |   |   |   |   |   |   |   |
| 10 | 30 | 29 | 28 | 27 | 26 | 25 |   |   |   |   |   |   |   |
| 11 |    |    |    |    |    |    |   |   |   |   |   |   |   |
| 12 | 31 | 32 | 33 | 34 | 35 | 36 |   |   |   |   |   |   |   |
| 13 |    |    |    |    |    |    |   |   |   |   |   |   |   |

**NOTE:** Not more than 2 corners, all in the same town and range, may be recorded on this certificate.

**A. Description of original monument and accessories and/or subsequent restoration:**

1843: ORIGINAL GOVERNMENT NOTES

SET POST  
10" SPR. PINE N 4° W 75 LK.  
10" SPR. PINE N 23° E 28 LK.

MAY, 1955: CARL R. SMALL

JORDANVILLE SUBDIVISION LIBER 7 PAGE 15

1957: C.G. AIKMAN

LAKE HURON SAND BEACH SUBDIVISION NO. 6 LIBER 8 PAGES 8-10

5-1960: GOULD ENG.

LAKE HURON SAND BEACH SUBDIVISION NO. 7 LIBER 10 PAGES 3-4

**B. Description of corner evidence found and/or method applied in restoring or reestablishing corner:**


CORNER COULD NOT BE FOUND  
SURVEYED IN FROM PLAT INFORMATION

ACCEPTED BY THE IOSCO COUNTY  
SURVEY PEER GROUP AS THE  
OFFICIAL CORNER UNDER P.A.  
346 OF 1990 AT A MEETING  
HELD ON 9-22-98

*James H. Grogan*

**C. Description of monument for corner and accessories established to perpetuate locating the position of the corner:**

- 5/8 BAR WITH REMON CAP
- 20" WHITE PINE N 51° E 30.86
- 14" OAK N 21° E 27.40
- 12" OAK N 04° E 30.12
- 10" OAK N 48° W 33.23

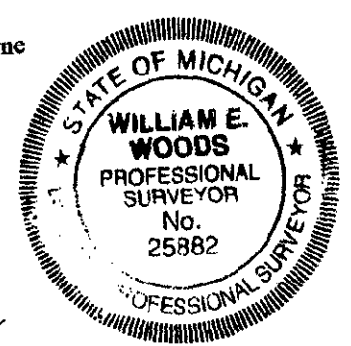

Signed by William E. Woods Date 12-9-98  
 WILLIAM E. WOODS P.S.

Surveyor's Michigan License No. 25882