


MAP SHEET


TOWN 24N RANGE 9E

DATE	FILE NO.
DIVISION	DISTRICT
MAPPED BY:	
PROTO NUMBERS	

COUNTY <u>Iosco</u>	TOWNSHIP	NUMBER OF ACRES
OWNER OF LAND		
PURPOSE OF MAP		

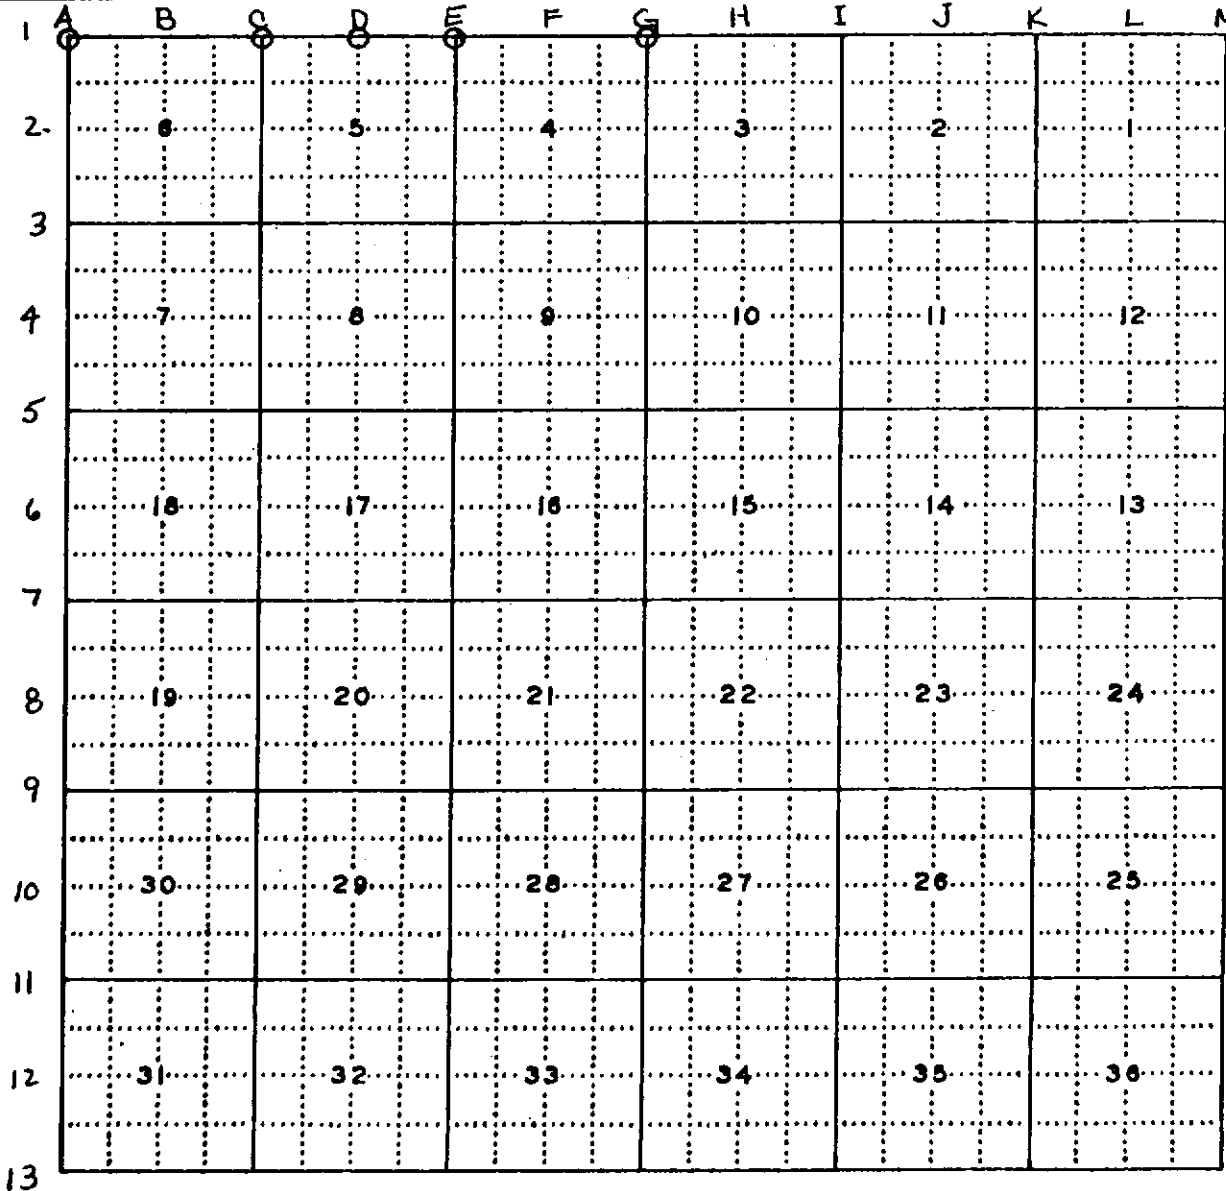

REMARKS

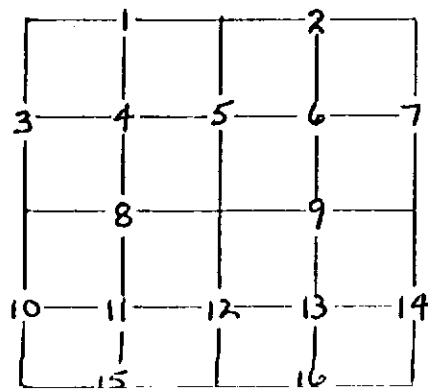

- denotes 2 records