

REMONUMENTATION CORNER

FEB 2 2 1996

LAND CORNER RECORDATION CERTIFICATE

FILING REQUIREMENT OF ACT 74, MICH. P.A.1970

COMMISSION

FOR CORNERS OF--:	LOCATED IN--:	CORNER CODE NUMBER
1. PUBLIC LAND SURVEY _____	24N N. 6E E. T. S., R. W.	J11
2. PROPERTY CONTROLLING IN SECTION _____	T. N. E. S., R. W.	
3. MISCELLANEOUS PROPERTY IN SECTION _____	T. N. E. S., R. W.	
4. LOT NO. _____, RECORDED PLAT _____		
5. PRIVATE CLAIMS _____		

STATE OF MICHIGAN
IOSCO COUNTY
FILED

29 NOV 95 12:20 P.M.

BONITA M. COYLE
REGISTER OF DEEDS

95-06

REGISTER OF DEEDS STAMP AND
FILING NUMBER

I, Patrick R. Leemon do hereby certify that under requirements of P.A. 74, Michigan P.A. of 1970, the corner points mentioned in lines 1 and 2 above (identified with circles on index code diagram - over) were, in a field survey on April, 17 1995, established, re-established, monumented, re-monumented, recovered or restored as expressed below and in conformance with regulations and rules therefore as required in the current manual of survey instructions of the United States Department of the Interior, Bureau of Land Management or by a decree of a court of law. Furthermore, that the corner points mentioned in lines 3, 4 and 5 above were, in a field survey on _____ 19____, found, recovered, restored, established or re-established as expressed below and in conformance with the rules of the Michigan State Board of Registration for Land Surveyors or, by a Decree of a Court of law:

A. Description of original monument and accessories and/or subsequent restoration:
1/4 Corner common to Sections 26 and 35 of T24N R6E

1845 GLO survey by James Mullett Set wood post, (1) Spruce Pine 4 S46E 22 links, (2) Spruce Pine 6 N2W 25 links

1909 survey by Fargo Eng. Co. Found both GLO witnesses and set a wood post, (3) Pine 8 S71-30E 214.5 links, (4) B.Oak 12 N48-15W 541 links

1927 GLO Dependent Resurvey by Guy Veal Found the Fargo post and witness (4) and set a 1"x36" iron pipe w/ brass cap, (5) B.Oak 4 N30E 216 links, (6) J.Pine 8 S3W 376 links

B. Description of corner evidence found and/or method applied in restoring or re-establishing corner:

I recovered the GLO brass cap monument flush with the ground and 14 feet south of the centerline of FR 4420 and 436 feet west of the centerline of River Road. I did not search for witnesses 1 through 6. I found the line from the S1/4 26 to the SE 26 to measure 2619.83 feet when compared to the Dependent Resurvey distance of 2618.88 feet.

C. Description of monument for corner and accessories established to perpetuate locating the position of the corner:
1/4 Corner common to Sections 26 and 35 of T24N R6E

I left the 1"x36" iron pipe with brass cap as I found it.

- R.Pine 12 N57E 63.82 feet
- R.Pine 11 S13E 29.78 feet
- R.Pine 10 S64W 34.24 feet
- R.Pine 11 N19W 36.68 feet
- Fiberglass Post East 0.6 feet

ACCEPTED BY THE IOSCO COUNTY
SURVEY PEER GROUP AS THE
OFFICIAL CORNER UNDER P.A.
345 OF 1990 AT A MEETING
HELD ON 10-31-95

James H. Kranger


SIGNED BY Patrick R. Leemon DATE May 30, 1995

SURVEYOR'S MICHIGAN REGISTRATION NO. 31595

FOR STATE AND UNITED STATES AGENCIES:

SIGNED BY _____ DATE _____
CHIEF OF SURVEY PARTY

APPROVED AND SIGNED BY _____ DATE _____
MICHIGAN REGISTERED LAND SURVEYOR

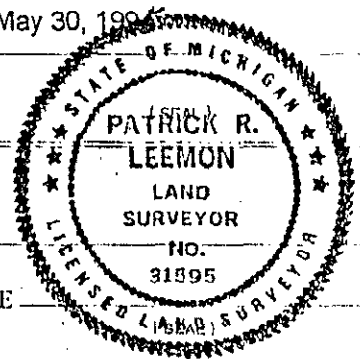

SURVEYOR'S MICHIGAN REGISTRATION NO. _____