

**LAND CORNER RECORDATION CERTIFICATE**  
**Filing Requirement of Act 74, Mich. P.A. 1970 as Amended**

For corners in

Iron	Located In:	Corner Code #
(County)		
1. Public Land Survey	T 41N R 32W	I5
	T 41N R 32W	J1
	T _____ R _____	_____
2. Property Controlling in Section	S _____ T _____ R _____	_____
	S _____ T _____ R _____	_____
3. Miscellaneous Property in Sec.	S _____ T _____ R _____	_____
	S _____ T _____ R _____	_____

Register of Deeds Stamp & File Number

4. Lot No. \_\_\_\_\_, Recorded Plat \_\_\_\_\_  
 5. Private Claims J1 Sep 19 2006  
 I5 Sep 18 2006

	A	B	C	D	E	F	G	H	I	J	K	L	M
1													
2	6	5	4	3	2	1							
3													
4	7	8	9	10	11	12							
5													
6	18	17	16	15	14	13							
7													
8	19	20	21	22	23	24							
9													
10	30	29	28	27	26	25							
11													
12	31	32	33	34	35	36							
13													

I, Stephan J. Szyszkoski, in a field survey on \_\_\_\_\_, 20\_\_\_\_ do hereby state that under requirements of P.A. 74, Michigan P.A. of 1970, the corner points mentioned in lines 1 and 2 above were in conformance with regulations and rules therefore as required in the current manual of survey instructions of the United States Department of the Interior, Bureau of Land Management or by a decree of a Court of Law and /or that the corner points mentioned in lines 3, 4 and 5 above were in conformance with the rules of the Michigan Board of Land Surveyors or by a Decree of a Court of Law; established, re-established, monumented, recovered, found as expressed below:

**NOTE: Not more than 2 corners, all in the same town and range, may be recorded on this certificate.**

**A. Description of original monument and accessories and/or subsequent restoration:**

(I5) Corner common to Sections 10-11-14-15. 1977 - Reestablished by proportionate measurement by A.O. Enger RLS. Mr. Enger set 1" IDx36" iron pipe with 3 3/4" aluminum cap. Witnesses: Cedar 7 S70W 14.6', Cedar 7 S42E 2.4', Cedar 9 N29W 6.2', squared and scribed cedar 5" S51E, 0.6' to center.

(J1) Quarter corner common to Section 2 T41N-R32W and Section 35 T42N-R32W. 1846 - Established by Wm. A. Burt, Deputy Surveyor, midway and on the township line between standard section corners I1 and K1 40 chains west and east. Set ironwood post. Sugar 16 NB 1/2E 30 links, Sugar 10 N12 1/2W 23 links. Circa 1943 - Corner reestablished by Wisconsin-Michigan Power Company by unknown method but presumed to be by single proportionate measurement to the original record between Section corners east and west. A 1947 WMPCO map shows "no evidence" found and set "concrete marker" with witnesses 4" poplar N12E 6.3', and 5" poplar S83W 20.6'.

**B. Description of corner evidence found and/or method applied in restoring or reestablishing corner:**


(I5) Recovered the 1977 monument in good condition and at record bearing and distance from the 1977 Cedar NBTs and the squared and scribed cedar SE, all in good condition. The squared Cedar and the NBTs SE and NW were cut to facilitate GPS observations. Left the monument in place and made new witnesses as described below.

(J1) The original monument and accessories were not recovered. Found the WMPCO monument of record, a 7" right-rectangular concrete pyramid with brass cap stamped to identify the corner, in good condition. The WMPCO witnesses were not recovered. My measurements show this monument is located 0.3' south and 3.4' west from the single proportionate position between Section corners I1 and K1. I accept the monument as a careful and faithful reestablishment of the position of the original corner. Made new witnesses as described below.

**C. Description of monument for corner and accessories established to perpetuate locating the position of the corner:**

(I5) Fd. 1" ID 1. pipe with 3 3/4" alum. MDNR cap. Set measuring nails in:  
 7" Cedar S47W 15.1' old scribing \*  
 5" Cedar N47W 10.5' mrkd "S10 NBT"  
 5" Cedar N09E 26.8' "S11 NBT"  
 6" Cedar S88E 20.5' "S14 NBT"  
 Bearings are magnetic. Distances are to nail with tag. \* denotes 1977 NBT

(J1) Fd. WMPCO concrete monument. Set measuring nails in:  
 5" W.Spruce N7E 8.1' mrkd "1/4S NBT"  
 11" Maple in clump S56E 43.3' do  
 12" W.Pine S36W 34.5' do  
 6" W.Spruce N79W 19.2' do  
 Set a sq'd cedar post adjacent.  
 Bearings are magnetic. Distances are to nail with tag.

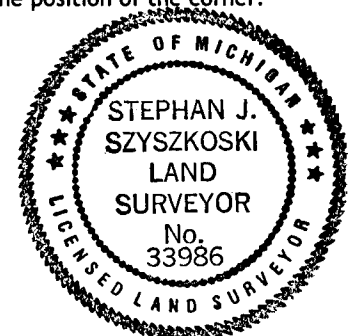

Signed by Stephan J. Szyszkoski  
 Surveyor's Michigan License No. 33986

Date 9/26/06

For the Michigan Department of Natural Resources, Office of Land and Facilities