LAND CORNER RECORDATION CERTIFICATE
Filing Requirement of Act 74, Micn. P.A. 1970 as Amended

For corners in

Iron
(County)

	Located In:			Corner Code #
1. Public Land Survey		T____	R____	
		T____	R____	
		T____	R____	
	S____	T____	R____	
2. Property Controlling	S 2	T 41N	R 32W	8
in Section	S 11	T 41N	R 32W	5
3. Miscellaneous	S____	T____	R____	
Property in Sec.	S____	T____	R____	

Register of Deeds Stamp & File Number

4. Lot No. _____ , Recorded Plat_____

5. Private Claims

5 Sep 06 2006
8 Sep 05 2006

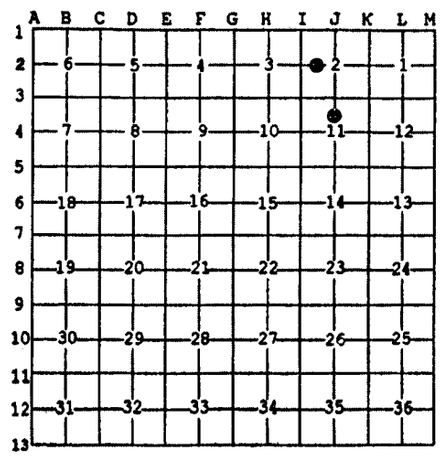

I, Stephan J. Szyszkoski, in a field survey on _____, 20 ____ do hereby state that under requirements of P.A. 74, Michigan P.A. of 1970, the corner points mentioned in lines 1 and 2 above were in conformance with regulations and rules therefore as required in the current manual of survey instructions of the United States Department of the Interior, Bureau of Land Management or by a decree of a Court of Law and /or that the corner points mentioned in lines 3, 4 and 5 above were in conformance with the rules of the Michigan Board of Land Surveyors or by a Decree of a Court of Law; established, re-established, monumented, recovered, found as expressed below:

NOTE: Not more than 2 corners, all in the same town and range, may be recorded on this certificate.

A. Description of original monument and accessories and/or subsequent restoration:

(8-Sec. 2) West 1/16 corner, Section 2. Not established in the original survey.
(5-Sec. 11) North 1/16 corner, Section 11. Not established in the original survey.

B. Description of corner evidence found and/or method applied in restoring or reestablishing corner:

(8-Sec. 2) Established the corner midway and on a straight line between Quarter corner 1318.15' West and the intersection of Quarter lines of Section 2, 1318.15' East.
(5-Sec. 11) Established the corner midway and on a straight line between Center of Section 1318.47' south and Quarter corner 1318.47' north. The position for the corner falls on the western edge of a N-S rock windrow. The monument was driven to refusal then made firm with rock. The monument leans slightly to the east but the top center of the cap marks the position for the corner.

C. Description of monument for corner and accessories established to perpetuate locating the position of this corner:

(8) Set 1"IDx32" I.pipe with 4" alum. MDNR cap. Set measuring nails in:

13" Oak N23E 21.4'	mrkd "1/16S BT"
12" Oak S43E 26.8'	do
15" Oak S15E 14.4'	do
8" twin Oaks S52W 3.3'	do

Bearings are magnetic. Distances are to nail with tag.

(5) Set 1"IDx32" I.pipe with 4" alum. MDNR cap. Set measuring nails in:

13" Oak N79W 24.9'	mrkd "1/16S BT"
8" Maple in clump S50W 39.7'	do
8" twin Maple N34W 45.4'	do
12" Oak N02E 37.5'	do

Set sq'd maple post adjacent. Bearings are magnetic. Distances are to nail with tag.

STATE OF MICHIGAN
STEPHAN J. SZYSZKOSKI
LAND SURVEYOR
No. 33986
LICENSED LAND SURVEYOR

Signed by Stephan J. Szyszkoski Date 9/26/06

Surveyor's Michigan License No. 33986

For the Michigan Department of Natural Resources, Office of Land and Facilities

FORM APPROVED BY MICHIGAN STATE BOARD OF PROFESSIONAL SURVEYORS, JAN. 28, 1971
Revised May 14, 1975
Revised Jan., 1983
Rervised Oct., 1995