

**LAND CORNER RECORDATION CERTIFICATE**  
**Filing Requirement of Act 74, Mich. P.A. 1970 as Amended**

For corners in

Iron	Located In:	Corner Code #
(County)		
1. Public Land Survey	T ___ R ___	_____
	T ___ R ___	_____
	T ___ R ___	_____
2. Property Controlling in Section	S ___ T ___ R ___	_____
	S 34 T 42N R 31W	8
	S 34 T 42N R 31W	5
3. Miscellaneous Property in Sec.	S ___ T ___ R ___	_____
	S ___ T ___ R ___	_____
4. Lot No. _____, Recorded Plat _____		
5. Private Claims		

Register of Deeds Stamp & File  
Number

	A	B	C	D	E	F	G	H	I	J	K	L	M
1													
2	6	5	4	3	2	1							
3													
4	7	8	9	10	11	12							
5													
6	18	17	16	15	14	13							
7													
8	19	20	21	22	23	24							
9													
10	30	29	28	27	26	25							
11													
12	31	32	33	34	35	36							
13													

Apr 12 2004

I, Stephan J. Szyszkoski, in a field survey on \_\_\_\_\_, 20\_\_ do hereby state that under requirements of P.A. 74, Michigan P.A. of 1970, the corner points mentioned in lines 1 and 2 above were in conformance with regulations and rules therefore as required in the current manual of survey instructions of the United States Department of the Interior, Bureau of Land Management or by a decree of a Court of Law and /or that the corner points mentioned in lines 3, 4 and 5 above were in conformance with the rules of the Michigan Board of Land Surveyors or by a Decree of a Court of Law; established, re-established, monumented, recovered, found as expressed below:

**NOTE: Not more than 2 corners, all in the same town and range, may be recorded on this certificate.**

**A. Description of original monument and accessories and/or subsequent restoration:**


- (8-Sec. 34) West 1/16 corner Section 34. Not established in the original survey.
- (5-Sec. 34) North 1/16 corner Section 34. Not established in the original survey.

**B. Description of corner evidence found and/or method applied in restoring or reestablishing corner:**

- (8-Sec. 34) Established the corner midway between Center of Section (unmonumented) 1325.30' East and G12 1325.30' West.
- (5-Sec. 34) Established the corner midway and on a straight line between Center of Section (unmonumented) 1339.44' South and H11 1339.44' North.

**C. Description of monument for corner and accessories established to perpetuate locating the position of the corner:**

- |   |  |
|---|--|
| (8) Set 1"x32" I.pipe with 4" alum. MDNR cap. Blazed, scribed, and set meas. nails in 3 BTs:<br>4" Spruce S84E 4.3'      "1/16S BT"<br>6" Spruce S43E 14.3'      do<br>6" Poplar S07W 8.52'      do<br>Fd. 3.5"x5.9ft. tall pipe N67W 5.4' to the SE face of the pipe. Bearings are magnetic. Distances are to nail with tag. | (5) Set 1"IDx32" I.pipe with 4" alum. MDNR cap. Blazed, scribed, and-set measuring nails in:<br>8" Spruce S33W 49.22'      "1/16S BT"<br>9" Spruce N65W 35.72'      do<br>6" Spruce N38E 45.82'      do<br>8" Balsam S60E 23.96'      do<br>Bearings are magnetic. Distances are to nail with tag. |
|---|--|

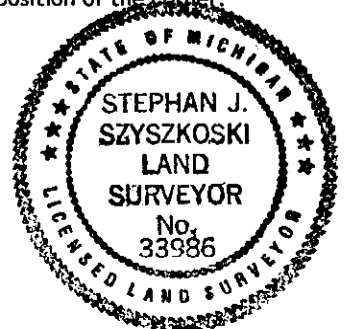

Signed by *Stephan J. Szyszkoski*  
 Surveyor's Michigan License No. 33986

Date 5/25/04