## LAND CORNER RECORDATION CERTIFICATE
**Filing Requirement of Act 74, Mich. P.A. 1970 as Amended**

For corners in

Iron (County)

| | | Located In: | | Corner Code # |
|---|---|---|---|---|
| 1. Public Land Survey | | T___ | R___ | |
| | | T___ | R___ | |
| | | T___ | R___ | |
| | S___ | T___ | R___ | |
| 2. Property Controlling | S 34 | T 42N | R 31W | 4 |
| in Section | S 34 | T 42N | R 31W | 12 |
| 3. Miscellaneous | S___ | T___ | R___ | |
| Property in Sec. | S___ | T___ | R___ | |

Register of Deeds Stamp & File Number

4. Lot No. _____ , Recorded Plat_____
5. Private Claims

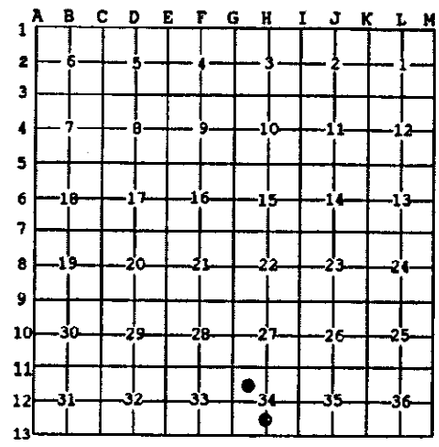


Apr 12 2004

I, Stephan J. Szyszkoski, in a field survey on _____, 20 ____ do hereby state that under requirements of P.A. 74, Michigan P.A. of 1970, the corner points mentioned in lines 1 and 2 above were in conformance with regulations and rules therefore as required in the current manual of survey instructions of the United States Department of the Interior, Bureau of Land Management or by a decree of a Court of Law and /or that the corner points mentioned in lines 3, 4 and 5 above were in conformance with the rules of the Michigan Board of Land Surveyors or by a Decree of a Court of Law; established, re-established, monumented, recovered, found as expressed below:

**NOTE: Not more than 2 corners, all in the same town and range, may be recorded on this certificate.**

A. Description of original monument and accessories and/or subsequent restoration:

(4-Sec. 34) Northwest 1/16 corner, Section 34. Not established in the original survey.
(12-Sec. 34) South 1/16 corner, Section 34. Not established in the original survey.

B. Description of corner evidence found and/or method applied in restoring or reestablishing corner:

(4-Sec. 34) Established the corner at the intersection of straight lines connecting opposite 1/16 corners. From the position thus established, a N-S steel cable, affixed to a metal fence post, is easterly 29' distant.
(12-Sec. 34) Established the corner midway and on a straight line between Center of Section (unmonumented) 1321.30' North and N13 1321.30' South.

C. Description of monument for corner and accessories established to perpetuate locating the position of the corner:

(4) Set 1"IDx32" I.pipe with 4" alum. MDNR cap. Blazed, scribed, and set measuring nails in:

| | |
|---|---|
| 15" W.Spruce N20E 11.8' | "1/16S BT" |
| 6" B.Spruce S08E 8.0' | do |
| W.Spruce N65W 41.0' | do |
| 6" Maple N20W 27.9' | do |

Bearings are magnetic. Distances are to nail with tag.

(12) Set 1"IDx32" I.pipe with 4" alum. MDNR cap. Blazed, scribed, and set measuring nails in:

| | |
|---|---|
| 4" Poplar N65E 12.7' | "1/16S BT" |
| 4" Poplar S35E 26.4' | do |
| 4" Poplar S07W 2.95' | do |
| 4" Poplar S77W 43.5' | do |

Bearings are magnetic. Distances are to nail with tag.

STATE OF MICHIGAN
STEPHAN J. SZYSZKOSKI
LAND SURVEYOR
No. 33986
LICENSED LAND SURVEYOR

Signed by Stephan J. Szyszkoski Date 5/25/04

Surveyor's Michigan License No. 33986

For the Michigan Department of Natural Resources, Office of Land and Facilities

FORM APPROVED BY MICHIGAN STATE BOARD OF PROFESSIONAL SURVEYORS, JAN. 28, 1971
Revised May 14, 1975
Revised Jan., 1983
Revised Oct., 1995