(70)

LAND CORNER RECORDATION CERTIFICATE
Filing Requirement of Act 74, Mich. P.A. 1970

For corners in

Iron
(County)

	Located In:	Corner Code #
1. Public Land Survey	T 42N R 31W	C7
	T 42N R 31W	D9
	T___ R___	
	T___ R___	
2. Property Controlling	S___ T___ R___	
in Section	S___ T___ R___	
3. Miscellaneous	S___ T___ R___	
Property in Sec.	S___ T___ R___	

Register of Deeds Stamp & File Number

4. Lot No. _____, Recorded Plat _____
5. Private Claims _____

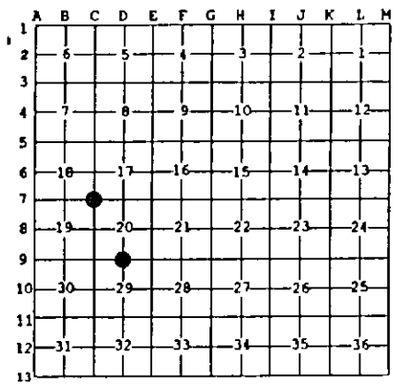

Aug 07 1996

I, Stephan J. Szyszkoski, in a field survey on _____, 19___ do hereby state that under requirements of P.A. 74, Michigan P.A. of 1970, the corner points mentioned in lines 1 and 2 above were in conformance with regulations and rules therefore as required in the current manual of survey instructions of the United States Department of the Interior, Bureau of Land Management or by a decree of a Court of Law and /or that the corner points mentioned in lines 3, 4 and 5 above were in conformance with the rules of the Michigan Board of Land Surveyors or by a Decree of a Court of Law; established, re-established, monumented, recovered, found as expressed below:

NOTE: Not more than 2 corners, all in the same town and range, may be recorded on this certificate.

A. Description of original monument and accessories and/or subsequent restoration:

(C7) Corner common to Sections 17-18-19-20. Corner established in 1849 by John Burt: "80.00 Set W. Pine post corner of Sections 17,18,19,20. Y. Pine 12 S55E 17, S. Pine 12 N75W 23." Records of Wisconsin Michigan Power Company (now Wisconsin Electric Power Company) in the form of a map titled PROPERTY MARKERS PAINT AND MICHIGAMME RIVERS map #G-21-GG dated 4/10/1947 show in regard to this corner "Chainage checked Gov. notes at swamps and ridges to south. set concrete marker. 10" Norway pine S48E 371.0', 7" cedar post N71W 114.0'". This monument was recovered and used in 1985 by Keith Sackett, RLS to reestablish the 1/4 corner common to Sections 17-18 and to establish the 1/16 corner between.

(D9) Quarter corner common to Sections 20-29. Corner established in 1849 by John Burt: "40.15 Set Y. Birch quarter Sect post. Maple 10 N24E 24, Y. Birch 8 S72W 23". Found no subsequent record.

B. Description of corner evidence found and/or method applied in restoring or reestablishing corner:

(C7) Original post and accessories not recovered. WMPCO witnesses not recovered. Found a 7" truncated right rectangular prism shaped concrete monument with a 3" square brass cap affixed on top which is stamped "Wisconsin Michigan Power Company 42-31 16-17-20-21". The monument was found in the midst of a large cultivated field and was probably hit at one time with an implement as it was found leaning slightly. The monument was righted and accepted as the best available evidence of the postion of the original corner. Distances N,S,E, and W to adjacent section corners check with the original record. To aid in locating the monument in the future, it's coordinates were determined to be 46 deg. 01 min. 45.00267 sec. North Latitude, and 88 deg. 13 min. 16.59350 sec. West Longitude NAD83(1994).

(D9) Original post and accessories not recovered. Found no evidence of the position of the original corner on the ground. Reestablished the corner by single proportionate measurement to the original record between section corners 2654.08' east and west. At the position for the corner, I placed a 1"I.D.x32" iron pipe capped with a 4" dia. cast aluminum MDNR tablet, appropriately stamped.

C. Description of monument for corner and accessories established to perpetuate locating the position of the corner:

(C7) Found WMPCO concrete monument. No witness objects available in the area. The corner falls in a large cultivated field. Placed a 6' blue carsonite post with location poster affixed adjacent to the monument.

(D9) Set 1" pipe with 4" MDNR cap. Blazed and scribed the following new bearing trees:

9" Maple S30E 34.9'	"1/4S NBT"
9" Maple S31W 60.0'	"1/4S NBT"
10" Maple N85W 46.6'	"1/4S NBT"
4" Balsam N48E 25.9'	"1/4S NBT"

Bearings are magnetic.

STATE OF MICHIGAN
STEPHAN J. SZYSZKOSKI
LAND SURVEYOR
No. 33986
LICENSED LAND SURVEYOR

Signed by Stephan J. Szyszkoski Date 9-9-96

Surveyor's Michigan License No. 33986

For the Michigan Department of Natural Resources - Forest Management Division

FORM APPROVED BY MICHIGAN STATE BOARD OF PROFESSIONAL SURVEYORS, JAN. 28, 1971
REVISED MAY 14, 1975
REVISED JAN., 1983
REVISED OCT., 1995