

SURVEY & REMONUMENTATION

JAN 13 1998

SECTION

LAND CORNER RECORDATION CERTIFICATE
Filing Requirement of Act 74, Mich. P.A. 1970

IRON COUNTY
MICHIGAN
RECEIVED FOR RECORD

97 DEC 23 PM 1:31
L.C. Records L.P. 172

Gilbert Stiles
REGISTER OF DEEDS

For corners in

<u>Iron</u> (County)	Located In:	Corner Code #
1. Public Land Survey	T <u>42N</u> R <u>33W</u>	<u>M-3</u>
	T <u>42N</u> R <u>32W</u>	<u>A-3</u>
	T _____ R _____	_____
	T _____ R _____	_____
2. Property Controlling in Section	S _____ T _____ R _____	_____
	S _____ T _____ R _____	_____
3. Miscellaneous Property in Sec.	S _____ T _____ R _____	_____
	S _____ T _____ R _____	_____

Register of Deeds Stamp & File Number

4. Lot No. _____, Recorded Plat _____
5. Private Claims _____

Section Corner Common to Sec. 1 & 12, T42N, R33W and Sec. 6 & 7, T42N, R32W

I, Gary L. Pisoni, in a field survey on December 1, 1997 do hereby state that under requirements of P.A. 74, Michigan P.A. of 1970, the corner points mentioned in lines 1 and 2 above were in conformance with regulations and rules therefore as required in the current manual of survey instructions of the United States Department of the Interior, Bureau of Land Management or by a decree of a Court of Law and/or that the corner points mentioned in lines 3, 4 and 5 above were in conformance with the rules of the Michigan Board of Land Surveyors or by a Decree of a Court of Law; established, re-established, monumented, recovered, found as expressed below:

	A	B	C	D	E	F	G	H	I	J	K	L	M
1													
2	6		5		4		3		2		1		
3													
4	7		8		9		10		11		12		
5													
6	18		17		16		15		14		13		
7													
8	19		20		21		22		23		24		
9													
10	30		29		28		27		26		25		
11													
12	31		32		33		34		35		36		
13													

NOTE: Not more than 2 corners, all in the same town and range, may be recorded on this certificate.

A. Description of original monument and accessories and/or subsequent restoration:

Original corner established in 1846 by Austin Burt, U.S. Deputy Surveyor.
Original Corner: Wood Post
Original Bearing Trees:
Yellow Birch 8" S 78° E 17 lks (11.22 feet)
Yellow Birch 16" N 54° W 15 lks (9.90 feet)
On September 25, 1849, Zelotes B. Searls established the following bearing tree:
Sugar 12" N 30° E 15 lks (9.90 feet)

PEER GROUP APPROVED
Gary L. Pisoni 12-19-97
COUNTY REPRESENTATIVE
J. Reed

B. Description of corner evidence found and/or method applied in restoring or reestablishing corner:

No evidence of original B.T.s found.

Corner position marked by a 1" dia. Iron bar in a 12"x12" concrete slab. Corner was probably set by the local mining company many years ago and is located along a steel tower high voltage utility line.

Distance to: E 1/4 Corner Section 12 S 00° 06'14"E 2637.56' (meas.) 2640' (GLO)
N 1/4 Corner Section 12 S 89° 40'26"W 2619.92' (meas.) 2616.90 (GLO)
E 1/4 Corner Section 1 N 00° 10'14"E 2635.06' (meas.) 2640. (GLO)


Accept the iron bar in concrete as the best available evidence for restoring the corner position.

Corner record research on file with County Representative.

C. Description of monument for corner and accessories established to perpetuate locating the position of the corner:

At the corner position marked by an iron bar in concrete, set a reference monument which is a 2" dia. by 30" long aluminum pipe monument, 3" above ground surface with a 3" dia. aluminum cap stamped as follows: Iron County Remonumentation R.M. T42N, R33W, R32W, S1, S6, S12, S7, S47° W, 1.30 ft, 1997, RLS 27457 from which the following bear: (measurements taken to a nail in side of tree)

R.M.	2"x30" Al. Pipe	N 47° E	1.30 feet
Sugar	6"	S 85° E	83.20 feet
Red Maple	8"	S 69° W	70.73 feet
Cherry	7"	N 21° W	106.00 feet
Steel sign post		N 47° E	1.9 feet

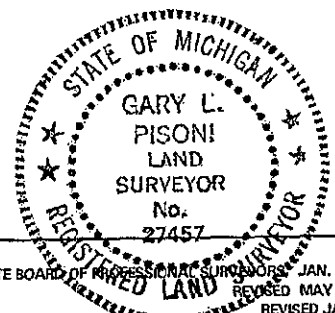

97-2b
Signed by *Gary L. Pisoni*
Surveyor's Michigan License No. 27457

Date December 16, 1997