

**SURVEY & REMONUMENTATION**

**JAN 13 1998**

**SECTION**

**LAND CORNER RECORDATION CERTIFICATE**  
 Filing Requirement of Act 74, Mich. P.A. 1970

IRON COUNTY  
 MICHIGAN  
 RECEIVED FOR RECORD

97 DEC 23 PM 1:31  
 L.C. Records 67P. 171

*Gibson & Stiles*  
 REGISTER OF DEEDS

For corners in


<u>Iron</u> (County)	Located In:	Corner Code #
1. Public Land Survey	T <u>42N</u> R <u>33W</u>	<u>M-5</u>
	T <u>42N</u> R <u>32W</u>	<u>A-5</u>
	T _____ R _____	_____
	T _____ R _____	_____
2. Property Controlling in Section	S _____ T _____ R _____	_____
	S _____ T _____ R _____	_____
3. Miscellaneous Property in Sec.	S _____ T _____ R _____	_____
	S _____ T _____ R _____	_____

Register of Deeds Stamp & File Number

4. Lot No. \_\_\_\_\_, Recorded Plat \_\_\_\_\_  
 5. Private Claims \_\_\_\_\_

Section Corner Common to Sec. 12 & 13, T42N, R33W and 7 & 18, T42N, R32W

I, Gary L. Pisoni, in a field survey on December 1, 1997 do hereby state that under requirements of P.A. 74, Michigan P.A. of 1970, the corner points mentioned in lines 1 and 2 above were in conformance with regulations and rules therefore as required in the current manual of survey instructions of the United States Department of the Interior, Bureau of Land Management or by a decree of a Court of Law and /or that the corner points mentioned in lines 3, 4 and 5 above were in conformance with the rules of the Michigan Board of Land Surveyors or by a Decree of a Court of Law; established, re-established, monumented, recovered, found as expressed below:

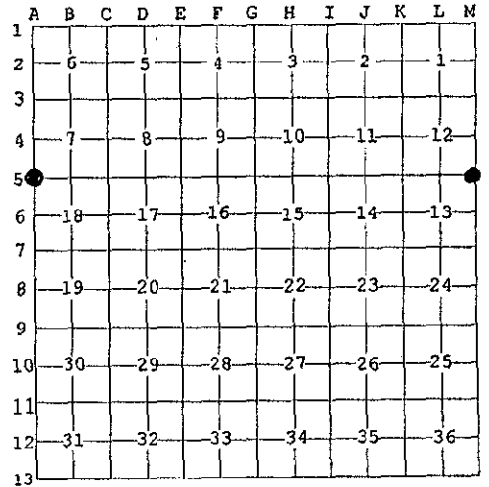

NOTE: Not more than 2 corners, all in the same town and range, may be recorded on this certificate.

A. Description of original monument and accessories and/or subsequent restoration:  
 Original corner established in 1846 by Austin Burt, U.S. Deputy Surveyor.  
 Original corner: Wood Post  
 Original Bearing Trees:

Hemlock	24"	S 50° W	29 lks (19.14 feet)
White Pine	8"	N 72° E	19 lks (12.54 feet)
On September 24, 1849, Zelotes B. Searles established the following bearing tree:			
Hemlock	10"	S 60° E	11 lks (7.26 feet)

**PEER GROUP APPROVED**  
*Gary L. Pisoni 12-19-97*  
**COUNTY REPRESENTATIVE**  
 FRM

B. Description of corner evidence found and/or method applied in restoring or reestablishing corner:  
 No evidence of original B.T.s found.

Corner marked by a railroad spike, set by an unknown person, 6.5' South of a curved centerline. Corner is in line with an old fence line to the East and in line with the centerline of Co. Road 424 to the West.

Distances from the South quarter corner of Section 12 to the Southeast corner of Section 12 check very close to the platted distance of the Plat of Alpha. Accepted the railroad spike as the best available evidence for restoring the corner position.

Corner record research on file with County Representative.

C. Description of monument for corner and accessories established to perpetuate locating the position of the corner:  
 At the Section corner position marked by a railroad spike, set two reference monuments which are a 2" dia. by 30" long aluminum pipe monument, 3" above ground surface with a 3" aluminum cap stamped as follows:  
 Iron County Remonumentation, R.M. T42N, R33W, R32W, S12, S7, S13, S18, N53° E, 56.69 feet, 1997, RLS 27457  
 and Iron County Remonumentation, R.M. T42N, R33W, R32W, S12, S7, S13, S18, S11° E, 66.69 feet, 1997, RLS 27457  
 from which the following bear (measurements taken to a nail in side of tree)

Jack Pine	12"	N 26° E	90.25 feet
R.M.	2"x30" Al.Pipe	S 53° W	56.69 feet
Jack Pine	11"	N 40° W	84.29 feet
R.M.	2"x30" Al.Pipe	N 11° W	66.69 feet
Steel sign post		N 11° W	67.3 feet
Steel sign post		S 53° W	57.3 feet

97-1b  
 Signed by *Gary L. Pisoni*  
 Surveyor's Michigan License No. 27457

Date December 16, 1997

