

**SURVEY & REMONUMENTATION**

APR 27 1995

**COMMISSION**

**LAND CORNER RECORDATION CERTIFICATE**  
Filing Requirement of Act 74, Mich. P.A. 1970

IRON COUNTY MICHIGAN  
RECEIVED FOR RECORD

95 JAN 17 AM 8:42  
L.C. RECORDS L.6 P.333

*Liber & Page*  
REGISTER OF DEEDS

Register of Deeds Stamp & File Number

For corners in  
Iron  
(County)

Located In: Corner Code #

- |                                    |                           |            |
|------------------------------------|---------------------------|------------|
| 1. Public Land Survey Section 8    | T <u>42N</u> R <u>32W</u> | <u>C-4</u> |
|                                    | T _____ R _____           | _____      |
|                                    | T _____ R _____           | _____      |
|                                    | T _____ R _____           | _____      |
| 2. Property Controlling in Section | S _____ T _____ R _____   | _____      |
|                                    | S _____ T _____ R _____   | _____      |
| 3. Miscellaneous Property in Sec.  | S _____ T _____ R _____   | _____      |
|                                    | S _____ T _____ R _____   | _____      |

4. Lot No. \_\_\_\_\_, Recorded Plat \_\_\_\_\_
5. Private Claims \_\_\_\_\_  
One-quarter corner common to Sections 7 and 8, T42N, R32W.

	A	B	C	D	E	F	G	H	I	J	K	L	M
2	6	5	4	3	2	1							
3													
4	7	8	9	10	11	12							
5													
6	13	17	16	15	14	13							
7													
8	19	20	21	22	23	24							
9													
10	30	29	28	27	26	25							
11													
12	31	32	33	34	35	36							
13													

I, John R. Garske, in a field survey on October 18, 1994 do hereby certify that under requirements of P.A. 74, Michigan P.A. of 1970, the corner points mentioned in lines 1 and 2 above were in conformance with regulations and rules therefore as required in the current manual of survey instructions of the United States Department of the Interior, Bureau of Land Management or by a decree of a Court of Law and/or that the corner points mentioned in lines 3, 4 and 5 above were in conformance with the rules of the Michigan Board of Land Surveyors or by a Decree of a Court of Law; established, re-established, monumented, re-monumented, recovered, found as expressed below:

NOTE: Not more than 4 corners, all in the same town and range, may be recorded on this certificate.

A. Description of original monument and accessories and/or subsequent restoration:

Original survey by J.B. Seal on September 24, 1849. Set hemlock post from which a 12" sugar - S38°W, 34 links.

April 29, 1971, survey by Michigan Department of Natural Resources surveyor, Arthur O. Enger, RLS 13581. Set 1" I.D. x 36" galvanized iron pipe with a 4" aluminum description cap, 13" R. oak - N30°W, 23.4 feet; 13" R. oak - N27°E, 21.1 feet. Enger found a rotting wood post set vertically in the ground while digging for placement of the above mentioned monument.

B. Description of corner evidence found and/or method applied in restoring or reestablishing corner:

Found Michigan Department of Natural Resources monument as noted above. Corner position was re-established midway on line between a known original section corner 39.96 chs. south and a probable original section corner 39.96 chs. north. Position agrees with GLO calls, as per Enger notes.


PEER GROUP APPROVED  
*John R. Garske*  
COUNTY REPRESENTATIVE

County Record Research and field search forms on file with County Representatives offices.

APR 12-15-94

C. Description of monument for corner and accessories established to perpetuate locating the position of the corner:

Updated Michigan Department of Natural Resources monument to state and county specifications. Established the following bearing trees and reference object: 16" oak - N29°E, 21.81 feet; 12" oak - S01°E, 24.88 feet; 8" basswood - N71°W, 13.72 feet; 16" oak - N29°W, 25.25 feet; 6' steel rail with sign - North - 0.88 feet.

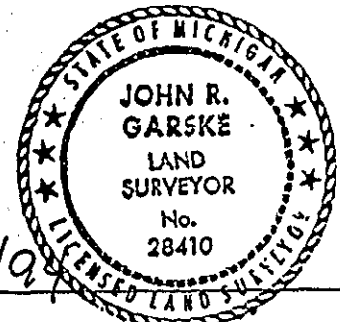

Signed by John R. Garske Date 12/12/94  
Surveyor's Michigan License No. 28410

FORM APPROVED BY MICHIGAN STATE BOARD OF LAND SURVEYORS, JAN. 28, 1971  
REVISED MAY 14, 1975  
REVISED JAN., 1983