

SURVEY & REMONUMENTATION

FEB 21 2001

SECTION

LAND CORNER RECORDATION CERTIFICATE
Filing Requirement of Act 74, Mich. P.A. 1970

COMMENCING YEAR 2000
 RECEIVED FOR RECORD
 IRON COUNTY, MICHIGAN

00 DEC -5 PM 12: 48

L.C. Records: 1, 8, P. 193

Robert A. Goodreau
 REGISTERED SURVEYOR

For corners in
IRON

(County)

Located In:

Corner Code #


- | | | |
|------------------------------------|---------------------------|-------|
| 1. Public Land Survey | T <u>42N</u> R <u>31W</u> | A-1 |
| | T <u>43N</u> R <u>31W</u> | A-13 |
| | T <u>42N</u> R <u>32W</u> | M-1 ✓ |
| | T <u>43N</u> R <u>32W</u> | M-13 |
| 2. Property Controlling in Section | S _____ T _____ R _____ | _____ |
| | S _____ T _____ R _____ | _____ |
| 3. Miscellaneous Property in Sec. | S _____ T _____ R _____ | _____ |
| | S _____ T _____ R _____ | _____ |

Register of Deeds Stamp & File Number

4. Lot No. _____, Recorded Plat _____
5. Private Claims _____

I, Robert A. Goodreau, in a field survey on November 17, 2000 do hereby state that under requirements of P.A. 74, Michigan P.A. of 1970, the corner points mentioned in lines 1 and 2 above were in conformance with regulations and rules therefore as required in the current manual of survey instructions of the United States Department of the Interior, Bureau of Land Management or by a decree of a Court of Law and/or that the corner points mentioned in lines 3, 4 and 5 above were in conformance with the rules of the Michigan Board of Land Surveyors or by a Decree of a Court of Law; established, re-established, monumented, recovered, found as expressed below:

NOTE: Not more than 2 corners, all in the same town and range, may be recorded on this certificate.

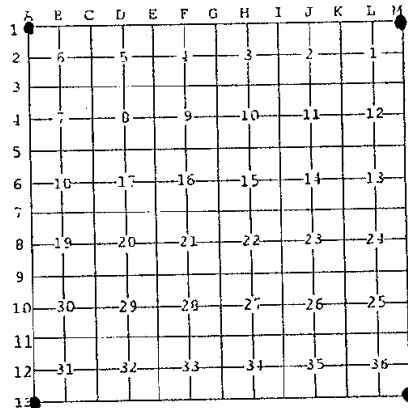

A. Description of original monument and accessories and/or subsequent restoration:

Original corner established by John Burt, U.S. Deputy Surveyor, on 30 July 1846.
 Original corner: Tamarack post
 Original witnesses: Tamarack 5" N20°E 10 links
 Tamarack 7" S45°W 17 links

Arthur O. Enger, RLS found and accepted a pipe set by an unknown surveyor on 9 July 1974. He witnessed and replaced it with a 1" ID x 39" iron pipe with a 3.5" aluminum cap. He stated "corner agrees substantially with other corners to N, S, and W of it and with margin of a small lake 4.55 ch. to E. (Record distance: 4.82 ch.)" (Liber 1, Page 355-356).

B. Description of corner evidence found and/or method applied in restoring or reestablishing corner:

Found corner as described by Enger.

No witnesses found.

County record research on file with county representative.

PEER GROUP APPROVED
Iron Range Assoc 11-30-2000
 COUNTY REPRESENTATIVE

C. Description of monument for corner and accessories established to perpetuate locating the position of the corner:

Accepted corner as found.

Note: Measurements taken to a nail in side of witnesses.

New witnesses: 6" Spruce S57°E 23.40'
 8" Tamarack S01°W 3.26'
 5" Tamarack N58°W 36.52'
 12" Red Pine N02°W 31.34'



Signed by *Robert A. Goodreau*
 Surveyor's Michigan License No. 43053

Date 11/22/00