

LAND CORNER RECORDATION CERTIFICATE
Filing Requirement of Act 74, Mich. P.A. 1970

For corners in
Iron

(County)

Located In:

Corner Code #

1. Public Land Survey	T <u>42N</u>	R <u>32W</u>	<u>D12</u>
	T <u> </u>	R <u> </u>	<u> </u>
	T <u> </u>	R <u> </u>	<u> </u>
	T <u> </u>	R <u> </u>	<u> </u>
2. Property Controlling in Section	S <u>32</u>	T <u>42N</u> R <u>32W</u>	<u>13</u>
	S <u> </u>	T <u> </u> R <u> </u>	<u> </u>
3. Miscellaneous	S <u> </u>	T <u> </u> R <u> </u>	<u> </u>
Property in Sec.	S <u> </u>	T <u> </u> R <u> </u>	<u> </u>

Register of Deeds Stamp & File Number

4. Lot No. _____, Recorded Plat _____
 5. Private Claims _____

Apr 23 2003

I, Stephan J. Szyszkoski, in a field survey on _____, 20____ do hereby state that under requirements of P.A. 74, Michigan P.A. of 1970, the corner points mentioned in lines 1 and 2 above were in conformance with regulations and rules therefore as required in the current manual of survey instructions of the United States Department of the Interior, Bureau of Land Management or by a decree of a Court of Law and/or that the corner points mentioned in lines 3, 4 and 5 above were in conformance with the rules of the Michigan Board of Land Surveyors or by a Decree of a Court of Law; established, re-established, monumented, recovered, found as expressed below:


NOTE: Not more than 2 corners, all in the same town and range, may be recorded on this certificate.

A	B	C	D	E	F	G	H	I	J	K	L	M
1												
2	6		5		4		3		2		1	
3												
4	7		8		9		10		11		12	
5												
6	10		17		16		15		14		13	
7												
8	19		20		21		22		23		24	
9												
10	30		29		28		27		26		25	
11												
12	31		●		33		34		35		36	
13												

A. Description of original monument and accessories and/or subsequent restoration:
 (D12) Center of Section 32. Not established in the original survey.
 (13-Sec. 32) Southeast 1/16 corner, Sec. 32. Not established in the original survey.

B. Description of corner evidence found and/or method applied in restoring or reestablishing corner:
 (D12) Established the corner at the intersection of straight lines connecting opposite 1/4 corners.
 (13-Sec. 32) Established the corner at the intersection of straight lines connecting opposite 1/16 corners.

C. Description of monument for corner and accessories established to perpetuate locating the position of the corner:
 (D12) Set 1"IDx32" I.pipe with 4" alum. MDNR cap. Blazed, scribed, and set measuring nails in:
 6" dbl Maple N71E 9.1' "C1/4 BT"
 3" Maple in clump S05W 17.0' do
 9" Sugar S57W 57.9' do
 5" twin Maples N47W 30.9' do
 Set sq'd spruce post adjacent. Bearings are magnetic. Distances are to nail with tag.
 (13) Set 1"IDx32" I.pipe with 4" alum. MDNR cap. Blazed, scribed, and set measuring nails in:
 5" Maple N86E 38.6' "1/16S BT"
 8" Maple S13E 50.1' do
 28" W.Pine S46W 54.7' do
 4" Maple in clump N21W 16.7' do
 Set sq'd maple post adjacent. Bearings are magnetic. Distances are to nail with tag.

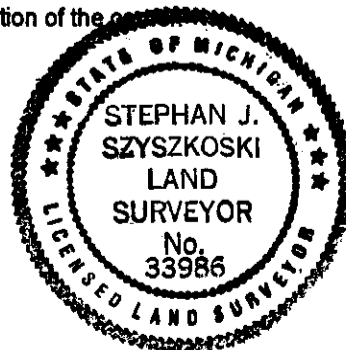

Signed by Stephan J. Szyszkoski
 Surveyor's Michigan License No. 33986

Date 6/2/03