

**LAND CORNER RECORDATION CERTIFICATE**  
**Filing Requirement of Act 74, Mich. P.A. 1970**

For corners in

Iron	Located In:	Corner Code #
(County)		
1. Public Land Survey	T 42NR 32W	C9
	T R	
	T R	
	T R	
2. Property Controlling in Section	S 29 T 42NR 32W	16
	S T R	
3. Miscellaneous Property in Sec.	S T R	
	S T R	

Register of Deeds Stamp & File Number

4. Lot No. \_\_\_\_\_, Recorded Plat \_\_\_\_\_  
 5. Private Claims \_\_\_\_\_

Jul 30 2003

I, Stephan J. Szyszkoski, in a field survey on \_\_\_\_\_, 20\_\_\_\_ do hereby state that under requirements of P.A. 74, Michigan P.A. of 1970, the corner points mentioned in lines 1 and 2 above were in conformance with regulations and rules therefore as required in the current manual of survey instructions of the United States Department of the Interior, Bureau of Land Management or by a decree of a Court of Law and/or that the corner points mentioned in lines 3, 4 and 5 above were in conformance with the rules of the Michigan Board of Land Surveyors or by a Decree of a Court of Law; established, re-established, monumented, recovered, found as expressed below:

**NOTE: Not more than 2 corners, all in the same town and range, may be recorded on this certificate.**

	A	B	C	D	E	F	G	H	I	J	K	L	M
1													
2	6		5		4		3		2		1		
3													
4	7		8		9		10		11		12		
5													
6	18		17		16		15		14		13		
7													
8	19		20		21		22		23		24		
9													
10	30		29		28		27		26		25		
11													
12	31		32		33		34		35		36		
13													

**A. Description of original monument and accessories and/or subsequent restoration:**  
 (C9) Corner common to Sections 19-20-29-30. Remonumented in 1970 by A.O. Enger from OBT stumps and a line tree stump 4.85 chains north. Set 1"IDx36" I.pipe with 4" alum. cap. Red Pine stump S16E 25 links (original BT stump), Red Pine stump N09E 49 links, W.Pine 5 S63W 79.2 links.

(16-Sec. 29) East 1/16 corner between Sections 29-32. Established in 1971 by A.O. Enger, RLS, midway and on line between Section and Quarter corners. Set 1"IDx36" I.pipe with 4" alum. cap. Red Oak 10 S44E 54.0', WMPC Power Pole #N35-176 N76W 92.2'

**B. Description of corner evidence found and/or method applied in restoring or reestablishing corner:**


(C9) Found the 1970 monument in good condition and at record bearing and distance from the NBT witnesses NE and SW. The stump NE is in good condition with scribing (S30 NBT) and notch visible. The W.Pine SW is in good condition with overgrown blazes. The OBT stump SE was not recovered. Accepted the corner position as found.

(16-Sec. 29) Found the 1971 monument as described but with a broken aluminum cap. Found the R.Oak NBT in good condition at substantial record bearing and distance. The power pole witness has been removed. The monument is 0.63' North and 0.08' West of the record position between Section and Quarter corners. Accepted the corner position as found.

**C. Description of monument for corner and accessories established to perpetuate locating the position of the corner:**

(C9) Found 1"ID I.pipe with 4" alum. NI Dept. of Conservation cap. Blazed, scribed, and set measuring nails in:  
 14" W.Pine S67W 52.3' overgrown blazes  
 6" W.Pine N89E 27.6' "S20 NBT"  
 5" W.Pine S45E 34.1' "S29 NBT"  
 15" W.Pine S80W 45.9' "S30 NBT"  
 Sq'd and scribed cedar post adjacent. Bearings are magnetic. Distances are to nail with tag.

(16) Found 1"ID I.pipe with 4" alum. cap, broken. Blazed, scribed, and set measuring nails in:  
 14" Oak S38E 54.7' overgrown blazes.  
 8" W.Pine S60E 63.4' "1/16S 8T"  
 4" W.Pine S38W 27.2' do  
 Set nail/tag in Power pole N71W 86.3'  
 Placed a sq'd cedar post adjacent. Bearings are magnetic. Distances are to nail with tag.

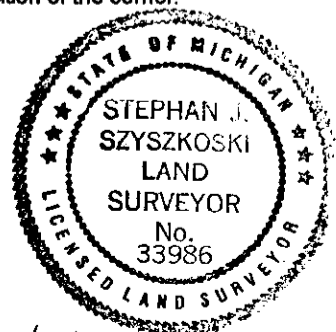

Signed by Stephan J. Szyszkoski  
 Surveyor's Michigan License No. 33986

Date 8/6/03