LAND CORNER RECORDATION CERTIFICATE
Filing Requirement of Act 74, Mich. P.A. 1970 as Amended

For corners in

Iron (County)

	Located In:		Corner Code #
1. Public Land Survey		T____ R____	
		T____ R____	
		T____ R____	
	S____	T____ R____	
2. Property Controlling	S 28	T 42N R 32W	9
in Section	S____	T____ R____	
3. Miscellaneous	S____	T____ R____	
Property in Sec.	S____	T____ R____	

Register of Deeds Stamp & File Number

4. Lot No. _____ , Recorded Plat_____

5. Private Claims

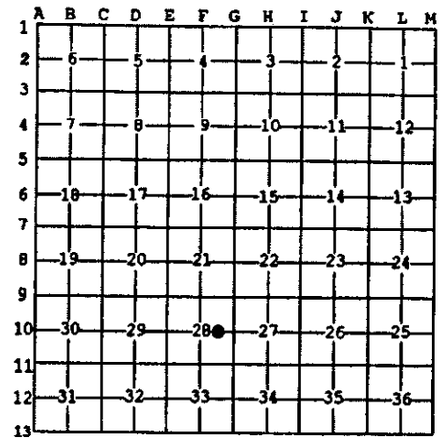

Jan 14 2004

I, Stephan J. Szyszkoski, in a field survey on _____, 20____ do hereby state that under requirements of P.A. 74, Michigan P.A. of 1970, the corner points mentioned in lines 1 and 2 above were in conformance with regulations and rules therefore as required in the current manual of survey instructions of the United States Department of the Interior, Bureau of Land Management or by a decree of a Court of Law and /or that the corner points mentioned in lines 3, 4 and 5 above were in conformance with the rules of the Michigan Board of Land Surveyors or by a Decree of a Court of Law; established, re-established, monumented, recovered, found as expressed below:

NOTE: Not more than 2 corners, all in the same town and range, may be recorded on this certificate.

A. Description of original monument and accessories and/or subsequent restoration:

(9-Sec. 28) East 1/16 corner, Section 28. Not established in the original survey.

B. Description of corner evidence found and/or method applied in restoring or reestablishing corner:

(9-Sec. 28) Established the corner midway and on a straight line between Quarter corner 1316.92' east and Center of Section 1316.92' west. The corner position falls in Seven Springs Lake and was not monumented. Established and monumented a witness corner on the 1/4 line 78.77' West of the position for the 1/16 corner. Established and monumented a second witness corner on the 1/4 line 836.73' East of the position for the 1/16 corner.

C. Description of monument for corner and accessories established to perpetuate locating the position of the corner:

(9) Set 1"IDx32" I.pipe with 4" alum. MDNR cap 78.77' West of the corner position and on the 1/4 line:

6" Oak N14E 30.4'	"WC BT"
8" Balsam N73E 8.6'	do
5" Oak S07W 33.5'	do
5" Oak N58W 43.8'	do

Bearings are magnetic. Distances are to nail with tag.

(9) Set a 1"IDx32" I.pipe with 4" alum. MDNR cap 836.73' East of the corner position and on the 1/4 line:

8" J.Pine N24W 24.8'	"WC BT"
7" J.Pine N71E 6.2'	do
7" J.Pine S74E 31.6'	do
10" R.Pine S05E 26.2'	do

Bearings are magnetic. Distances are to nail with tag.

STATE OF MICHIGAN
STEPHAN J. SZYSZKOSKI
LAND SURVEYOR
No. 33986
LICENSED LAND SURVEYOR

Signed by Stephan J. Szyszkoski Date 2/9/04

Surveyor's Michigan License No. 33986

For the Michigan Department of Natural Resources, Office of Land and Facilities

FORM APPROVED BY MICHIGAN STATE BOARD OF PROFESSIONAL SURVEYORS, JAN. 28, 1971
Revised May 14, 1975
Revised Jan., 1983
Revised Oct., 1995