LAND CORNER RECORDATION CERTIFICATE
Filing Requirement of Act 74, Mich. P.A. 1970 as Amended

For corners in

Iron (County)

		Located in:		Corner Code #
1. Public Land Survey		T___	R___	
		T___	R___	
		T___	R___	
	S___	T___	R___	
2. Property Controlling	S 28	T 42N	R 32W	2
in Section	S___	T___	R___	
3. Miscellaneous	S___	T___	R___	
Property in Sec.	S___	T___	R___	

Register of Deeds Stamp & File Number

4. Lot No. _____ , Recorded Plat_____
5. Private Claims

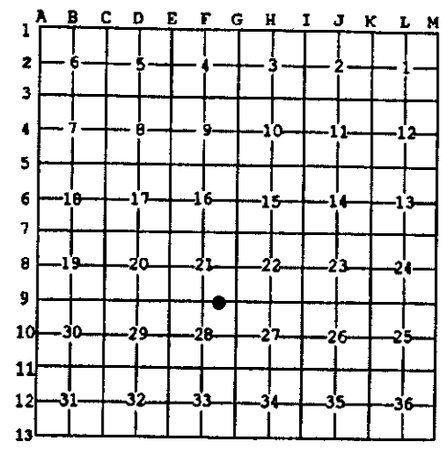

Jan 22 2004

I, Stephan J. Szyszkoski, in a field survey on _____, 20 ____ do hereby state that under requirements of P.A. 74, Michigan P.A. of 1970, the corner points mentioned in lines 1 and 2 above were in conformance with regulations and rules therefore as required in the current manual of survey instructions of the United States Department of the Interior, Bureau of Land Management or by a decree of a Court of Law and /or that the corner points mentioned in lines 3, 4 and 5 above were in conformance with the rules of the Michigan Board of Land Surveyors or by a Decree of a Court of Law; established, re-established, monumented, recovered, found as expressed below:

NOTE: Not more than 2 corners, all in the same town and range, may be recorded on this certificate.

A. Description of original monument and accessories and/or subsequent restoration:

(2-Sec. 28) East 1/16 corner between Sections 21 and 28. Corner established in 1971 and recorded by A.O.Enger RLS for the Michigan Dept. of Natural Resources. 1"IDx36" I.pipe with 4" aluminum cap. J.Pine 4 N22E 25.6', J.Pine 5 S74E 29.2', J.Pine 5 S52W 9.6'.

B. Description of corner evidence found and/or method applied in restoring or reestablishing corner:

(2-Sec. 28) Recovered the 1971 monument in good condition and verified its postion by approximate measurement between Section and Quarter corners. The snow cover obscures the remains, if any, of the 1971 witnesses, the area having been clearcut a number of years ago. Left the monument in place and made new witnesses as described below.

C. Description of monument for corner and accessories established to perpetuate locating the position of the corner:

(2) Found 1"ID I.pipe with 4" aluminum cap. Blazed, scribed, and set measuring nails in:

5" Oak N11E 45.4'	"1/16S BT"
8" R.Pine S43E 37.1'	do
5" R.Pine S56W 76.4'	do
10" Oak N62W 88.2'	do

Set sq'd cedar post adjacent. Bearings are magnetic. Distances are to nail with tag.

STATE OF MICHIGAN
STEPHAN J. SZYSZKOSKI
LAND SURVEYOR
No. 33986
LICENSED LAND SURVEYOR

Signed by Stephan J. Szyszkoski

Date 2/9/04

Surveyor's Michigan License No. 33986

For the Michigan Department of Natural Resources, Office of Land and Facilities

FORM APPROVED BY MICHIGAN STATE BOARD OF PROFESSIONAL SURVEYORS, JAN. 28, 1971
Revised May 14, 1975
Revised Jan., 1983
Revised Oct., 1995