

LAND CORNER RECORDATION CERTIFICATE
Filing Requirement of Act 74, Mich. P.A. 1970 as Amended

For corners in

<u>Iron</u> (County)	Located In:	Corner Code #
1. Public Land Survey	T <u>42N</u> R <u>32W</u>	<u>F12</u>
	T _____ R _____	_____
	T _____ R _____	_____
2. Property Controlling in Section	S _____ T _____ R _____	_____
	S <u>33</u> T <u>42N</u> R <u>32W</u>	<u>5</u>
	S _____ T _____ R _____	_____
3. Miscellaneous Property in Sec.	S _____ T _____ R _____	_____
	S _____ T _____ R _____	_____

Register of Deeds Stamp & File
Number

4. Lot No. _____, Recorded Plat _____
 5. Private Claims _____

Jan 15 2004

I, Stephan J. Szyszkoski, in a field survey on _____, 20 ____ do hereby state that under requirements of P.A. 74, Michigan P.A. of 1970, the corner points mentioned in lines 1 and 2 above were in conformance with regulations and rules therefore as required in the current manual of survey instructions of the United States Department of the Interior, Bureau of Land Management or by a decree of a Court of Law and /or that the corner points mentioned in lines 3, 4 and 5 above were in conformance with the rules of the Michigan Board of Land Surveyors or by a Decree of a Court of Law; established, re-established, monumented, recovered, found as expressed below:

NOTE: Not more than 2 corners, all in the same town and range, may be recorded on this certificate.

A. Description of original monument and accessories and/or subsequent restoration:

(F12) Center of Section 33. Not established in the original survey.
 (5-Sec. 33) North 1/16 corner, Sec. 33. Not established in the original survey.


B. Description of corner evidence found and/or method applied in restoring or reestablishing corner:

(F12) Established the corner at the intersection of straight lines connecting opposite 1/4 corners.
 (5-Sec. 33) Established the corner midway and on a straight line between Quarter corner F11 1318.12' north and Center of Section 33 1318.12' south.

C. Description of monument for corner and accessories established to perpetuate locating the position of the corner:

(F12) Set 1" IDx32" I.pipe with 4" alum. MDNR cap. Blazed, scribed, and set measuring nails in:	(5) Set 1" IDx32" I.pipe with 4" alum. MDNR cap. Blazed, scribed, and set measuring nails in:
4" Spruce N15E 27.3' "C1/4 BT"	12" triple Oak N11W 16.5' "1/16S BT"
7" Spruce N59E 43.5' do	12" Oak S47E 41.4' do
5" Maple S75E 34.4' do	10" Oak S28W 6.9' do
8" Maple S25E 44.0' do	4" R.Pine N27W 13.3' do
Set sq'd cedar post adjacent. Bearings are magnetic. Distances are to nail with tag.	Set sq'd cedar post adjacent. Bearings are magnetic. Distances are to nail with tag.

1	A	B	C	D	E	F	G	H	I	J	K	L	M
2	6		5		4		3		2		1		
3													
4	7		8		9		10		11		12		
5													
6	18		17		16		15		14		13		
7													
8	19		20		21		22		23		24		
9													
10	30		29		28		27		26		25		
11													
12	31		32				34		35		36		
13													

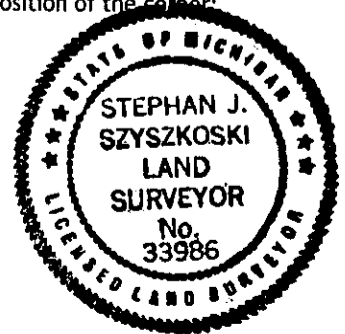

Signed by Stephan J. Szyszkoski
 Surveyor's Michigan License No. 33986

Date 2/9/04

For the Michigan Department of Natural Resources, Office of Land and Facilities